

Washington
 K 2008
 4/5/80

MISSISSIPPI
 BOARD OF WATER COMMISSIONERS
 416 North State Street
 Jackson, Mississippi 39201

WATER WELL DRILLERS LOG

5 apr 1980 Lambert Drilling Co Wash
 date well completed firm name county well located

LANDOWNER:	description of formations encountered	from	to
T. Zanders.			
Wayside, Miss. (mailing address)	Mixed	0	10
WELL LOCATION:	Sand.	10	66
sec. 10 T. 16 N R. 8 E W	Sand & gravel	60	94
10 miles S of Greenville	Clay blue	94	192
(distance) (direction) (nearest town)	clay	192	240
WELL PURPOSE: home (home, irrigation, municipal, industrial)	Clay st sand	240	290
WELL COMPLETION DATA:	Sand, med	290	405
(1) diameter (inches) 4x2	Sand good	405	450
(2) total depth (feet) 450			
(3) static water level (feet) 31 below top of ground.			
(4) casing PVC, 430 (material) (depth)			
4x2 (size) if telescope see back.			
(5) screen 20, 450-430 (length) (depth to top)			
2 1/2, PVC (size) (material)			
(6) pump 1, 20 (HP) (yield gpm)			
elect (type power)			
(7) electric log (yes or no)			
(organization running log)			
(8) how well bottom plugged back press.			
DRILLERS REMARKS:			

DEPT. OF NATURAL RESOURCES
 BUREAU OF LAND & WATER RESOURCES

MAY 29 1980

RECEIVED


If well telescopes please sketch and show depths.

GROUND LEVEL

140 4"

430 2"

450 2" scr.

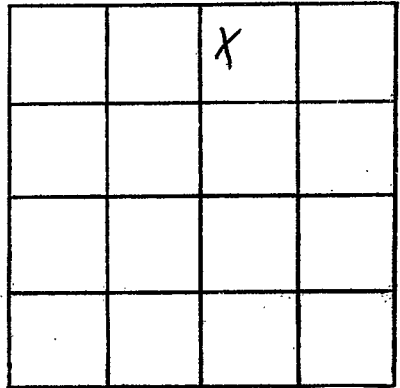

SECTION 10

Please indicate well location X.

ADDITIONAL INFORMATION

If more than one screen, show locations of each on sketch.