

MISSISSIPPI DEPARTMENT OF NATURAL RESOURCES

Bureau of Land and Water Resources

Southport Mall

P.O. Box 10631

Jackson, Mississippi 39209

WATER WELL DRILLERS LOG

Washington  
K 2009

513  
22

July 08 1981 Larry's Well & Pump Washington  
date well completed firm name county well located

LANDOWNER: <u>D.D. Tice</u>	description of formations encountered	from	to
<u>Hollandale, ms</u> (mailing address)	<u>CLAY</u>	<u>0'</u>	<u>14'</u>
	<u>SAND</u>	<u>14'</u>	<u>76'</u>
	<u>GRAVEL</u>	<u>96'</u>	<u>114'</u>
WELL LOCATION: sec. <u>33</u> T. <u>16</u> N. R. <u>8</u>	<u>CLAY</u>	<u>114'</u>	<u>240'</u>
<u>11</u> miles <u>W</u> of <u>Hollandale</u>	<u>SAND</u>	<u>240'</u>	<u>460'</u>
(distance) (direction) of (nearest town)	<u>CLAY</u>	<u>460'</u>	<u>500'</u>
	<u>SAND</u>	<u>500'</u>	<u>580'</u>
WELL PURPOSE: (home, irrigation, municipal, industrial)			
WELL COMPLETION DATA:			
(1) diameter (inches) <u>4" X 2"</u>			
(2) total depth (feet) <u>580'</u>			
(3) static water level (feet) <u>21</u> below above top of ground.			
(4) casing <u>PVC</u> , <u>120'</u> of <u>4"</u> (material) (depth) <u>440'</u> of <u>2"</u> (size) if telescope see back.			
(5) screen <u>10'</u> , <u>540'</u> (length) (depth to top) <u>2"</u> , <u>PVC</u> (size) (material)			
(6) pump <u>1</u> , <u>30</u> (HP) (yield gpm) <u>Electric's</u> (type power)			
(7) electric log <u>NO</u> (yes-or no)			
(organization running log)			
(8) how well bottom plugged <u>SAND SHARK</u>			
DRILLERS REMARKS:			


DEPT. OF NATURAL RESOURCES  
BUREAU OF LAND & WATER RESOURCES

JAN 8 1982

RECEIVED

If well telescopes please sketch and show depths.

GROUND LEVEL

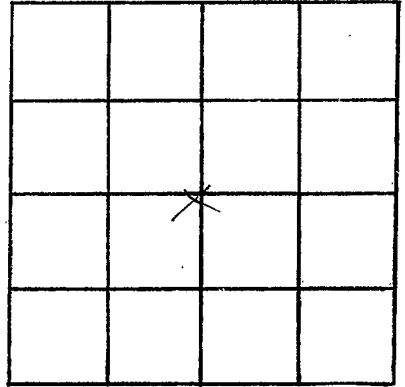

SECTION 33

Please indicate well location X.

ADDITIONAL INFORMATION

RECEIVED

82 JAN 8 A 8:42

If more than one screen, show locations of each on sketch.