

Washington
K2011

MISSISSIPPI
BOARD OF WATER COMMISSIONERS
416 North State Street
Jackson, Mississippi 39201

WATER WELL DRILLERS LOG

9-5 1983 Schultz Drilling Washington
date well completed firm name county well located

LANDOWNER: Don Ray
28 Council Circle
Greenville MS
(mailing address)

description of formations encountered	from	to
CLAY	0	20
SAND + Pea GRAVEL	20	90
CLAY	90	120
SANDY CLAY	120	370
SAND	370	430

WELL LOCATION:
sec. 8 T. 15 N R. 8 E
4 10 S miles S of Greenville
(distance) (direction) (nearest town)

WELL PURPOSE: home
(home, irrigation, municipal, industrial)


- WELL COMPLETION DATA:
- (1) diameter (inches) 2"
 - (2) total depth (feet) 430'
 - (3) static water level (feet) 24' below top of ground.
 - (4) casing PVC 420'
(material) (depth)
 - (size) if telescope see back.
 - (5) screen 10' 420'
(length) (depth to top)
 - 2" PVC
(size) (material)
 - (6) pump 1hp 10 gpm
(HP) (yield gpm)
 - D/E
(type power)
 - (7) electric log NO
(yes or no)
 - (organization running log)
 - (8) how well bottom plugged b/w

DRILLERS REMARKS:

DEPT. OF WATER RESOURCES
BUREAU OF WATER RESOURCES
SEP 26 1983
RECEIVED

If well telescopes please sketch and show depths.

GROUND LEVEL

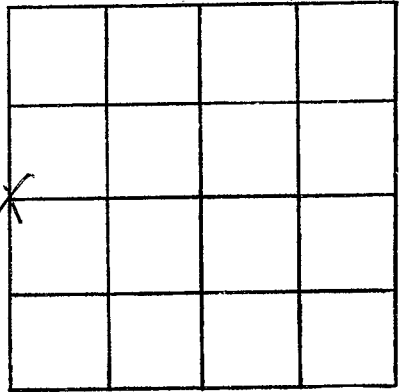

SECTION 15

Please indicate well location X.

ADDITIONAL INFORMATION

If more than one screen, show locations of each on sketch.