

MISSISSIPPI DEPARTMENT OF NATURAL RESOURCES

Bureau of Land and Water Resources

Southport Mall

P.O. Box 10631

Jackson, Mississippi 39209

WATER WELL DRILLERS LOG

WASHINGTON
K 2015

3-20 1987 Schultz Drilling Washington
date well completed firm name county well located

LANDOWNER: James Worthington
418 S. Euzeka Street
Greenville, MS
(mailing address)

description of formations encountered

from to

CLAY	0	30
SAND	30	88
CLAY	88	345
SAND	345	420

WELL LOCATION:

sec. 21 T. 16^N R. 8 E
4 miles W of Arcola
(distance) (direction) (nearest town)

WELL PURPOSE: HOME
(home, irrigation, municipal, industrial)

WELL COMPLETION DATA:

- (1) diameter (inches) 4" x 2"
- (2) total depth (feet) 420'
- (3) static water level (feet) 30' below above top of ground.
- (4) casing PVC 400 (material) (depth)
- (size) If telescope see back.
- (5) screen 20' 400' (length) (depth to top)
- 2" PVC (size) (material)
- (6) pump 1 20 (HP) (yield gpm)
- elb (type power)
- (7) electric log NO (yes or no)
- X (organization running log)
- (8) how well bottom plugged b/w


RECEIVED

MAR 25 1987

Department of Natural Resources
Bureau of Land & Water Resources

DRILLERS REMARKS:

If well telescopes please sketch and show depths.

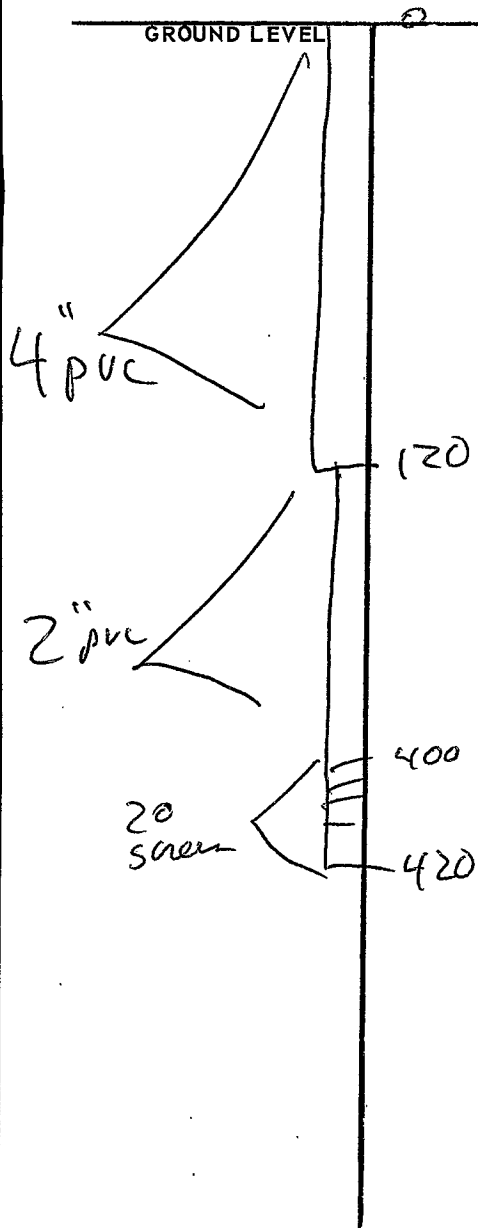

		X	

SECTION 21

Please indicate well location X.

ADDITIONAL INFORMATION

If more than one screen, show locations of each on sketch.