
COUNTY WELL L	OCATED	#5N	iissis	SIPPI					SOURCE	
WAS hine	CODED	PERMIT	JIIMBER			sureau	o <del>F</del> Land	and Wate	er Resource	
								Pί	O. Box 1063	
2025 Dry Well					Jackson, Mississippi 39209					
DATE WELL COM		- Jy-4	00 €			V			ILLERS LOC	
NAME & MAILING	ADDRESS OF LAN	DOWNER					PUMP [	ATA		
Musca	dire 1	- Brm	In	/c.	PUMP TYI	PE/Circle	One):		<del></del> ,	
					Submersit Other (Des	ole, C scribe) _	Turbine,	Jet	Flowing Well,	
					POWER TO	Tractor		, Gasoli H/P -		
WELL LOCATION: SEC TOWNSHIP RANGE					Pump Capacit	- 1	_	Setting Dep		
	19	16	Ø ,	8 A	150	0	2	60	) FT.	
DISTANCE	DIRECTI	ON	NEAREST		PUMP TEST					
Miles of					Well yielded GPM with					
					a drawdown of ft.					
WELL PURPOSE: Home, Irrigation, Municipal, Industrial, Kish Pond to.					after hours of pumping					
		LOG DATA								
Well Depth 74	16' 34   TYPE OF LOG RUN (Circle One): No Log Run, Electric, Gamma Ray, Density, Sonic, Neutron, Orbor (Pagariba)									
Type of Casing	Hole Depth	Depth to	Static Water	Level				····		
stul					Name of Orga	nization Ru	nning Log			
TYPE OF COMPLETION: (Circle One or More):  Gravel Packed Underreamed, Telescoped,					None					
Natural Development, Open Hole, Other (Describe)					GEOLOGIC DATA (Office Use Only)  Surface Elev. Geologic Unit Unit Thickness Depth to Top					
Top of Lap Pipe or Reduction in Casing					Odridoc Licv.	deolo	gicoliii		Depth to Top .	
FEET ONE SCREEN: USE BACK PAGE					Subs. SWL	Date	· A	nalysis	Aquifer Test	
F	E	Driller's Rema	rks							
Diameter - Inches	SCREEN Length - Feet		Slot Size - In	chae						
16"	40	′	.03	0						
Screen Type  Wire Wian  Depth to Bottom - Feet					FIGHER BILL					
00,111			•							
DESCRIPTION OF F	ORMATIONS ENC	OUNTERED	FROM	то			Continued)	1000	ROM TO	
<u> </u>	LIAY		0	24		٥	CT 2	3 12,10		
Fine	Same		24	48		<del></del>		, Re	COUTE ES	
Fine So	mel + Lha	mel .	48	70.			sent of h	Grand	Secol seco	
M Sand + Showl 70 74					Deputinent of Natural Resources					
				3ureuw						
· · · · · · · · · · · · · · · · · · ·			-							
					IF MORE SPACE IS NEEDED, USE BACK					

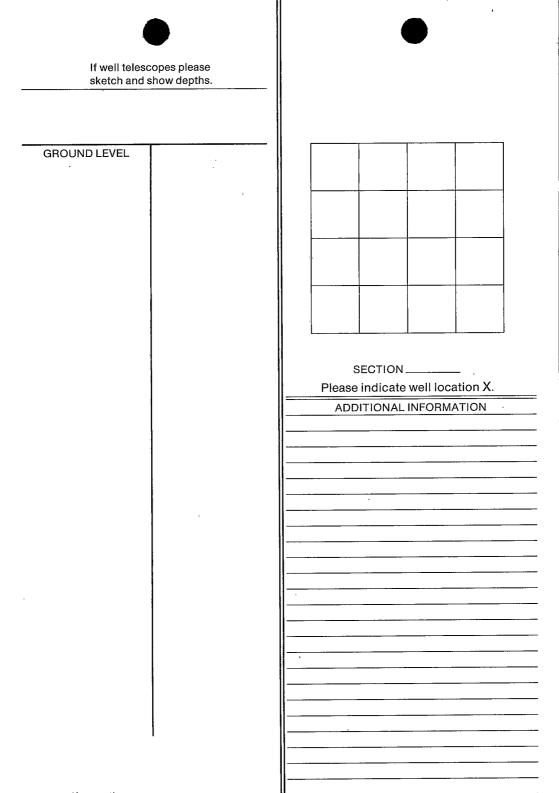

If more than one screen, show location of each on sketch.