

MISSISSIPPI DEPARTMENT OF NATURAL RESOURCES
Bureau of Land and Water Resources

P.O. Box 10631

Jackson, Mississippi 39209

WATER WELL DRILLERS LOG

COUNTY WELL LOCATED <i>Washington</i>		PERMIT NUMBER
WELL NUMBER <i>K</i>	CODED	
DATE WELL COMPLETED <i>7-19-90</i>		NAME OF DRILLING FIRM <i>Dyn Well</i>

NAME & MAILING ADDRESS OF LANDOWNER
Muscadine Farms Inc.

WELL LOCATION: SEC TOWNSHIP RANGE
19 16 (N) 8 (E)

DISTANCE DIRECTION NEAREST TOWN
_____ Miles of _____

OTHER LANDMARK

WELL PURPOSE: Home, Irrigation, Municipal, Industrial, Fish Pond, etc.

PUMP DATA

PUMP TYPE (Circle One):
Submersible, Turbine, Jet Flowing Well,
Other (Describe) _____

POWER TYPE (Circle One):
Electric, Tractor, Diesel, Gasoline, Butane,
Other (Describe) _____ H/P _____

Pump Capacity (GPM)	No. of Stages	Setting Depth
<i>1500</i>	<i>2</i>	<i>60</i> FT.

PUMP TEST

Well yielded _____ GPM with
a drawdown of _____ ft.
after _____ hours of pumping

WELL DATA

Well Depth <i>77'</i>	Casing Diameter (In.) <i>16"</i>	Casing Length (Ft.) <i>37'</i>
Type of Casing <i>steel</i>	Hole Depth	Depth to Static Water Level

TYPE OF COMPLETION: (Circle One or More):
Gravel Packed, Underreamed, Telescoped,
Natural Development, Open Hole, Other
(Describe) _____

Top of Lap Pipe or Reduction in Casing

FEET IF TELESCOPED OR MORE THAN ONE SCREEN: USE BACK PAGE

LOG DATA

TYPE OF LOG RUN (Circle One):
Electric, Gamma Ray, Density, Sonic, Neutron,
Other (Describe) No Log Run

Name of Organization Running Log
None

SCREEN DATA

Diameter - Inches <i>16"</i>	Length - Feet <i>40'</i>	Slot Size - Inches <i>.030</i>
Screen Type <i>Wire Wraps</i>	Depth to Bottom - Feet	

GEOLOGIC DATA (Office Use Only)

Surface Elev.	Geologic Unit	Unit Thickness	Depth to Top
Subs. SWL	Date	Analysis	Aquifer Test

Driller's Remarks

RECEIVED

OCT 26 1990


DESCRIPTION OF FORMATIONS ENCOUNTERED	FROM	TO	FORMATIONS (Continued)	FROM	TO
<i>CLAY</i>	<i>0</i>	<i>28</i>			
<i>Fine Sand</i>	<i>28</i>	<i>41</i>			
<i>Fine Sand + Gravel</i>	<i>41</i>	<i>71</i>			
<i>M Sand + Gravel</i>	<i>71</i>	<i>77</i>			

IF MORE SPACE IS NEEDED, USE BACK

Department of Natural Resources
Bureau of Land & Water Resources

If well telescopes please
sketch and show depths.

GROUND LEVEL

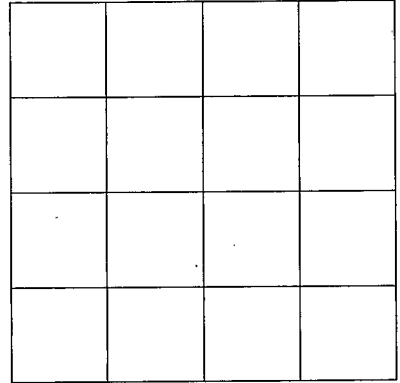

SECTION _____

Please indicate well location X.

ADDITIONAL INFORMATION

If more than one screen,
show location of each on sketch.