

MISSISSIPPI DEPARTMENT OF ENVIRONMENTAL QUALITY
Bureau of Land and Water Resources

COUNTY WELL LOCATED
Washington

WELL NUMBER 1 CODED

20241
DATE WELL COMPLETED
5-15-92

PERMIT NUMBER

NAME OF DRILLING FIRM
Schudco

1462 a 166A P. O. Box 10631
Jackson, MS 39289-0631
WATER WELL DRILLERS LOG

NAME & MAILING ADDRESS OF LANDOWNER
Hobart Bros

Box 71

Avon MS 38723

WELL LOCATION: SEC 12 TOWNSHIP 16 RANGE 8

4 Miles East of Wayside

OTHER LANDMARK

WELL PURPOSE: Home, Irrigation Municipal, Industrial, Fish Pond, etc.

PUMP DATA

PUMP TYPE (Circle One):
Submersible, Turbine Jet Flowing Well,
Other (Describe)

POWER TYPE (Circle One):
Electric, Tractor, Diesel Gasoline, Butane,
Other (Describe) H/P

Pump Capacity (GPM) No. of Stages Setting Depth

FT.

PUMP TEST

Well yielded _____ GPM with
a drawdown of _____ ft.
after _____ hours of pumping

WELL DATA

Well Depth <u>79</u>	Casing Diameter (In.) <u>16</u>	Casing Length (Ft.) <u>39</u>
Type of Casing <u>steel</u>	Hole Depth <u>79</u>	Depth to Static Water Level

TYPE OF COMPLETION: (Circle One or More):
Gravel Packed, Underreamed, Telescoped,
Natural Development, Open Hole, Other

(Describe) Hole Plug

Top of Lap Pipe or Reduction in Casing

FEET IF TELESCOPED OR MORE THAN ONE SCREEN: USE BACK PAGE

LOG DATA

TYPE OF LOG RUN (Circle One): No Log Run
Electric, Gamma Ray, Density, Sonic, Neutron,
Other (Describe)

Name of Organization Running Log

SCREEN DATA

Diameter - Inches <u>16</u>	Length - Feet <u>40</u>	Slot Size - Inches <u>1050</u>
Screen Type <u>steel</u>	Depth to Bottom - Feet <u>79</u>	

GEOLOGIC DATA (Office Use Only)


Surface Elev.	Geologic Unit	Unit Thickness	Depth to Top
Subs. SWL	Date	Analysis	Aquifer Test

Driller's Remarks

DESCRIPTION OF FORMATIONS ENCOUNTERED	FROM	TO	FORMATIONS (Continued)	FROM	TO
<u>Clay</u>	<u>0</u>	<u>18</u>	RECEIVED		
<u>sand</u>	<u>18</u>	<u>26</u>			
<u>sand Med P.C.</u>	<u>26</u>	<u>79</u>			
			AUG 10 1992		
			Dept. of Environmental Quality Bureau of Land & Water Resources		
			IF MORE SPACE IS NEEDED, USE BACK		

If well telescopes please
sketch and show depths.

GROUND LEVEL

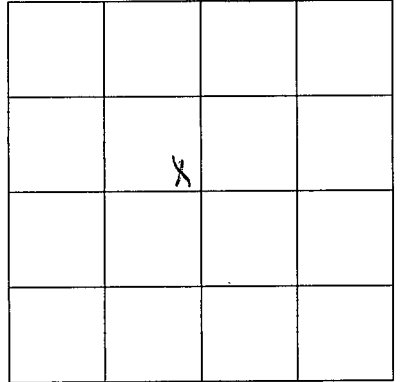

SECTION 12

Please indicate well location X.

ADDITIONAL INFORMATION

If more than one screen,
show location of each on sketch.