 



**MISSISSIPPI DEPARTMENT OF ENVIRONMENTAL QUALITY**  
Bureau of Land and Water Resources

P. O. Box 10631  
Jackson, MS 39289-0631  
**WATER WELL DRILLERS LOG**

COUNTY WELL LOCATED <i>Washington</i>	
WELL NUMBER <i>K</i>	CODED
DATE WELL COMPLETED <i>2043</i> <i>5-4-93</i>	

PERMIT NUMBER
NAME OF DRILLING FIRM <i>Schudco Ltd</i>

NAME & MAILING ADDRESS OF LANDOWNER <i>Bratton Farms</i>		
<i>HOLLANDALE MS</i>		
<i>38748</i>		
WELL LOCATION:	SEC	TOWNSHIP RANGE
	<i>32</i>	<i>16 S 8</i>  
DISTANCE	DIRECTION	NEAREST TOWN
<i>8</i> Miles	<i>West</i> of	<i>Hollandale</i>
OTHER LANDMARK		
WELL PURPOSE: <input checked="" type="checkbox"/> Home Irrigation, Municipal, Industrial, Fish Pond, etc.		

PUMP DATA		
PUMP TYPE (Circle One): <input checked="" type="checkbox"/> Submersible Turbine, Jet Flowing Well, Other (Describe) <i>owner</i>		
POWER TYPE (Circle One): <input checked="" type="checkbox"/> Electric, Tractor, Diesel, Gasoline, Butane, Other (Describe) <i>H/P 1</i>		
Pump Capacity (GPM)	No. of Stages	Setting Depth
		FT.
PUMP TEST		
Well yielded _____ GPM with a drawdown of _____ ft. after _____ hours of pumping		


WELL DATA		
Well Depth <i>280</i>	Casing Diameter (In.) <i>4 X 2</i>	Casing Length (Ft.) <i>260</i>
Type of Casing <i>pvc</i>	Hole Depth <i>320</i>	Depth to Static Water Level
TYPE OF COMPLETION: (Circle One or More): <input checked="" type="checkbox"/> Gravel Packed, <input type="checkbox"/> Underreamed, <input type="checkbox"/> Telescoped, <input checked="" type="checkbox"/> Natural Development, <input type="checkbox"/> Open Hole, <input type="checkbox"/> Other (Describe) <i>Hole plug + concrete</i>		
Top of Lap Pipe or Reduction in Casing		
FEET	IF TELESCOPED OR MORE THAN ONE SCREEN: USE BACK PAGE	

LOG DATA	
TYPE OF LOG RUN (Circle One): Electric, Gamma Ray, Density, Sonic, Neutron, Other (Describe) <input checked="" type="checkbox"/> No Log Run	
Name of Organization Running Log	

SCREEN DATA		
Diameter - Inches <i>2</i>	Length - Feet <i>20</i>	Slot Size - Inches <i>1'008</i>
Screen Type <i>pvc</i>	Depth to Bottom - Feet <i>280</i>	

GEOLOGIC DATA (Office Use Only)			
Surface Elev.	Geologic Unit	Unit Thickness	Depth to Top
Subs. SWL	Date	Analysis	Aquifer Test
Driller's Remarks			


DESCRIPTION OF FORMATIONS ENCOUNTERED	FROM	TO
<i>clay</i>	<i>0</i>	<i>40</i>
<i>sand + gravel</i>	<i>40</i>	<i>108</i>
<i>clay</i>	<i>108</i>	<i>220</i>
<i>sand</i>	<i>220</i>	<i>280</i>

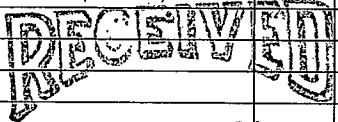FORMATIONS (Continued)	FROM	TO
		
<b>OCT 25 1993</b>		
Dept. of Environmental Office of Land & Water Resources		

IF MORE SPACE IS NEEDED, USE BACK

If well telescopes please sketch and show depths.

GROUND LEVEL

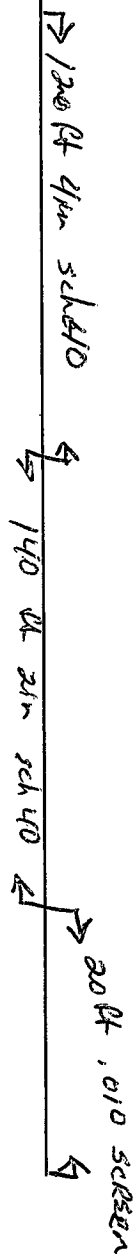

X			

SECTION 32

Please indicate well location X.

ADDITIONAL INFORMATION

If more than one screen, show location of each on sketch.