

Washington

L 33

MISSISSIPPI BOARD OF WATER COMMISSIONERS

5-66

WATER WELL DRILLERS LOG

Washington

Date: May 10, 19 66, Driller: Butane Gas Co.  
(Name)

County Leflore

(1) Owner of Land: Vernon Hammett  
(Name)  
Greenville, Miss.  
(Address)

(2) Location: Sw 1/4, Sw 1/4, Sec. 20 T11R14  
16 7  
9 miles South, of Greenville  
(distance) (direction) (Nearest Town)

(3) Topography: Flat  
(Hilly) (Flat) (Level)

(4) Purpose of Well: Irrigation  
(Domestic Irrigation  
Municipal, Industrial, Other)

Description & Color of Materials Sand, Clay, Red Clay, Shell, etc.	Thick- ness Feet	Depth Feet
<u>Clay</u>	<u>13</u>	<u>13</u>
<u>"</u>	<u>10</u>	<u>23</u>
<u>Fine Sand</u>	<u>10</u>	<u>33</u>
<u>"</u>	<u>10</u>	<u>43</u>
<u>"</u>	<u>10</u>	<u>53</u>
<u>Coarse Sand &amp; gravel</u>	<u>10</u>	<u>63</u>
<u>"</u>	<u>10</u>	<u>73</u>
<u>Hard Brown Clay</u>	<u>10</u>	<u>83</u>

Information upon completion of well:

(1) Diameter 16 inches.

(2) Total Depth 73 feet.

(3) Water Level 20 feet below top of ground.

(4) Cased to 43, Size 16

(5) Screen: Size 16, Length 30


(6) Were any formations sealed against pollution?

yes, X no.

If YES depth of formation \_\_\_\_\_

Why \_\_\_\_\_

Drillers Remarks: \_\_\_\_\_

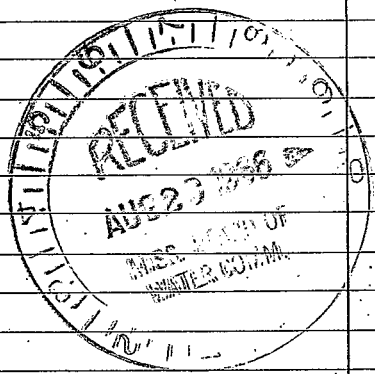

(Use Back Side)

Well No.

