


Washington
 L 34
 2-67

MISSISSIPPI
 BOARD OF WATER COMMISSIONERS
 416 North State Street
 Jackson, Mississippi 39201

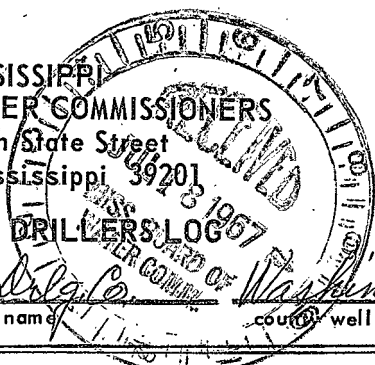

WATER WELL DRILLERS LOG

7/14 1967 date well completed
 Bailey Drilling Co. firm name
 Washington county well located

LANDOWNER: W C Boland
 Areola, Miss.
 (mailing address)

description of formations encountered	from	to
Clay	0	20
Sand	20	80
Gravel	80	90
Mud	90	265
Sand	265	378
Mud	378	480
Sand	480	578

WELL LOCATION:
 sec. 24 T. 16 N R. 7 W
 at Estill
 miles of (distance) (direction) (nearest town)

WELL PURPOSE: Home
 (home, irrigation, municipal, industrial)

WELL COMPLETION DATA:

- (1) diameter (inches) 4X2 1/2 X 2
- (2) total depth (feet) 578
- (3) static water level (feet) 26 below above top of ground.
- (4) casing Steel (material), (depth)
- 4X2 1/2 X 2 if telescope see back. (size)
- (5) screen 20' (length), 528 (depth to top)
- 2 (size), Stainless Steel (material)
- (6) pump 1 1/2 (HP), 25 (yield gpm)
- Elec (type power)
- (7) electric log No (yes or no)
- (organization running log)
- (8) how well bottom plugged Back pressure valve

DRILLERS REMARKS:

If well telescopes please sketch and show depths.

GROUND LEVEL

126' 11"

51' 3 1/2"

51' 3"

41' 11" (screen)

	X		

SECTION 34

Please indicate well location X.

ADDITIONAL INFORMATION

If more than one screen, show locations of each on sketch.