

Washington
L35
7-67

MISSISSIPPI
BOARD OF WATER COMMISSIONERS
416 North State Street
Jackson, Mississippi 39201
WATER WELL DRILLERS LOG

9/1/67
JW 2500

July 24, 1967 Layne-Central Company Washington
date well completed firm name county well located

LANDOWNER: W. D. Atterbury

description of formations encountered	from	to
Clay	0	16
Coarse sand	16	70
Coarse sand, pea gravel	70	112
Sand & gravel	112	184
Clay	184	224
Shale	224	267
Clay	267	320
Shale	320	365
Rock	365	366
Shale	366	384
Clay	384	457
Sand, clay strks.	457	497
White sand	497	561


Estill, Mississippi
(mailing address)

WELL LOCATION: NW NE
sec. 25 T. 16 N R. 7 E
on Hwy 61 S W
miles of Estill
(distance) (direction) (nearest town)

WELL PURPOSE: domestic
(home, irrigation, municipal, industrial)

WELL COMPLETION DATA:


- (1) diameter (inches) 4" x 3"
- (2) total depth (feet) 561
- (3) static water level (feet) 23 below top of ground.
- (4) casing steel, 523' (material), (depth)
4" x 3" if telescope see back.
(size)
- (5) screen 30' length, 553' depth to top
3" Stainless Steel (size) 3" Blank (material)
- (6) pump 1/2 HP, 30 (yield gpm)
electric (type power)
- (7) electric log no (yes or no)
(organization running log)
- (8) how well bottom plugged shot

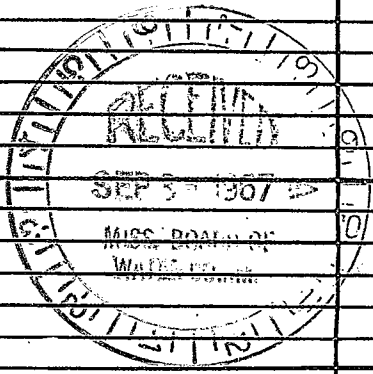

DRILLERS REMARKS:

If well telescopes please sketch and show depths.

GROUND LEVEL

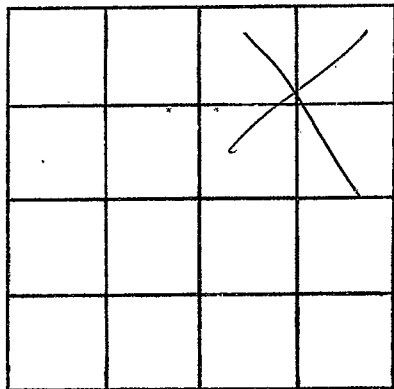

SECTION 25

Please indicate well location X.

ADDITIONAL INFORMATION

If more than one screen, show locations of each on sketch.