

**CODED**

Washington  
L37  
5-68

MISSISSIPPI  
BOARD OF WATER COMMISSIONERS  
416 North State Street  
Jackson, Mississippi 39201

WATER WELL DRILLERS LOG

5-28 1968 DYER WELL & IRR. WASHINGTON  
date well completed firm name county well located

LANDOWNER:

ALBERT PREDOT  
HOLLANDALE, MISS.  
(mailing address)

description of formations encountered

from to

CLAY	0	13
SOFT SANDY CLAY	13	23
MED. SAND	23	33
SAND SHOT WITH CLAY	33	43
FINE SAND	43	53
SAND & GRAVEL	53	63
COARSE SAND & GRAVEL	63	73
CLAY	73	84

WELL LOCATION:

sec 17 T. 16 N R. 7 W  
(distance) miles of (direction) of (nearest town)

WELL PURPOSE: IRRIGATION  
(home, irrigation, municipal, industrial)

WELL COMPLETION DATA:

- (1) diameter (inches) 16"
- (2) total depth (feet) 84'
- (3) static water level (feet) 22' below top of ground.
- (4) casing B.I. 52' (material), (depth), 16" (size) if telescope see back.
- (5) screen 32' 52' (length), (depth to top), 16" BERKINGOT (size), (material)
- (6) pump 50 1500 (HP), (yield gpm), DIESEL (type power)
- (7) electric log No (yes or no)
- (8) how well bottom plugged RATE


84'  
BOTTOM

DRILLERS REMARKS:

JUL 7 - 1968  
MISS. BOARD OF  
WATER COMM.

If well telescopes please sketch and show depths.

GROUND LEVEL

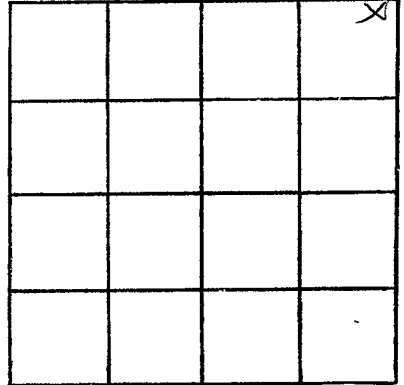

SECTION 17

Please indicate well location X.

ADDITIONAL INFORMATION

If more than one screen, show locations of each on sketch.