

Washington  
L38  
7-17-68

MISSISSIPPI  
BOARD OF WATER COMMISSIONERS  
416 North State Street  
Jackson, Mississippi 39201

CODE

WATER WELL DRILLERS LOG

7-17 1968 date well completed  
108 OVERWELL TERR. WASH. firm name  
county well located

LANDOWNER: V.C. HAMMITT JR.

description of formations encountered from to

R.R.

CLAY

0 13

Greenwood Miss.  
(mailing address)

CLAY

13 23

CLAY

23 29

FINE SAND

29 33

WELL LOCATION:

sec. 17 T. 16 N. R. 7 E. W.  
miles of (distance) (direction) (nearest town)

CLAY

33 38

MED. SAND

38 43

FINE SAND

53 63

FINE SAND & COR. GRA.

63 73

CORASE SAND & GRA.

73 104

WELL PURPOSE: FISH  
(home, irrigation, municipal, industrial)

CLAY

104'

WELL COMPLETION DATA:

(1) diameter (inches) 16"  
(2) total depth (feet) 104'  
(3) static water level (feet) 19 below above top of ground.

(4) casing PERK, 64',  
(material) (depth)  
16" If telescope see back.  
(size)

(5) screen 40', 64',  
(length) (depth to top)

16" BUC. IR.  
(size) (material)

(6) pump 30 1500  
(HP) (yield gpm)  
ELEC  
(type power)

(7) electric log NO  
(yes or no)

(organization running log)


(8) how well bottom plugged None

DRILLERS REMARKS:

Dec 2 1968  
MISS. BOARD OF WATER COMMISSIONERS

If well telescopes please sketch and show depths.

GROUND LEVEL

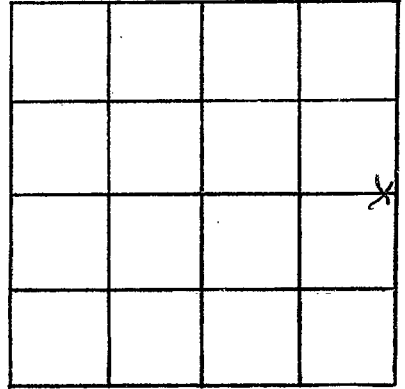

SECTION 17

Please indicate well location X.

ADDITIONAL INFORMATION

If more than one screen, show locations of each on sketch.