

L39
4-17-57

WATER WELL DRILLERS LOG

9/27/65
C 372

Date: April 17, 19 57, Driller: Layne-Central Company County Washington

(Name)

(1) Owner of Land: Fred Bueker
(Name)
Stuttgart, Arkansas
(Address)
(2) Location: 1/4, 1/4, Sec. 34 1649 W
T R
2 1/2 miles northwest of Hollandale
(distance) (direction) (Nearest Town)
(3) Topography: flat
(Hilly) (Flat) (Level)
(4) Purpose of Well: irrigation
(Domestic Irrigation
Municipal, Industrial, Other)

Description & Color of Materials Sand, Clay, Red Clay, Shell, etc.	Thick- ness Feet	Depth Feet
Blue clay	18	18
Coarse brown sand	14	32
Coarse blue sand	10	42
Coarse sand & pea rockel	20	62
Sand & gravel	20	82
Sand & gravel	20	102
Sand & big gravel	8	110

Information upon completion of well:

(1) Diameter 12 inches.
(2) Total Depth 110 feet.
(3) Water Level 10' 11" feet below top of ground.
(4) Cased to 60', Size 12"
(5) Screen: Size 12", Length 50'
(6) Were any formations sealed against pollution?
_____ yes, no no.

If YES depth of formation _____


Why _____

Drillers Remarks:

2316 GPM.

Electric power.

Info. info to locate

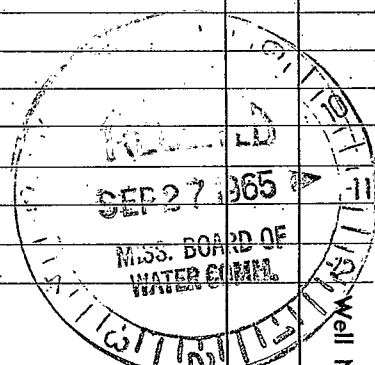

(Use Back Side)

