

WASH 'N

MISSISSIPPI BOARD OF WATER COMMISSIONERS

CODED

L40
2-13-63

WATER WELL DRILLERS LOG

CODED

Date: 2/13, 1963, Driller: Bailey Drilling Co
(Name)

County: Washington

(1) Owner of Land: J. L. Williams
(Name)
Hollandale, Miss
(Address)

(2) Location: 22 1/4, 1/4, Sec. 22 16N 21W
T R
4 miles west of Estill
(direction) (Nearest Town)

(3) Topography: Flat
(Hilly) (Flat) (Level)

(4) Purpose of Well: domestic
(Domestic Irrigation
Municipal, Industrial, Other)

Description & Color of Materials Sand, Clay, Red Clay, Shell, etc.	Thick- ness Feet	Depth Feet
Clay	18	18
Sand		85
Gravel		105
Mud		158
Sand		185
Mud		273
Sand		378

Information upon completion of well:

(1) Diameter: 2 1/2 x 2 inches.

(2) Total Depth: 378 feet.

(3) Water Level: 14 feet below top of ground.


(4) Cased to: all way, Size: 2 1/2 x 2

(5) Screen: Size: 2, Length: 10ft

(6) Were any formations sealed against pollution?
yes, no.

CODED

Insuff. info
to locate

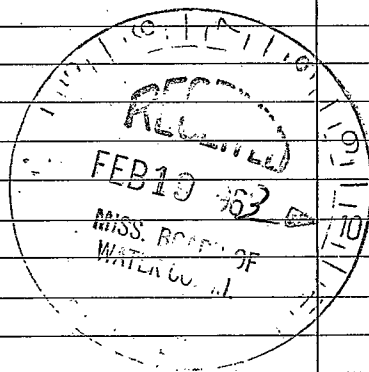

If YES depth of formation:

Why:

Drillers Remarks:

(Use Back Side)

Well No.

