

~~LA~~  
3-28-66

CODED

WATER WELL DRILLERS LOG

Date: 3/28, 1966, Driller: Bailey Drilling Co County: Washington  
(Name)

(1) Owner of Land: <u>Alex Gates</u> (Name) <u>Wayside, Miss.</u> (Address)	Description & Color of Materials Sand, Clay, Red Clay, Shell, etc.	Thick- ness Feet	Depth Feet
	<u>Clay</u>		<u>20</u>
	<u>Sand</u>		<u>82</u>
	<u>Gravel</u>		<u>102</u>
(2) Location: <u>1/4</u> , <u>1/4</u> , Sec <u>6</u> <u>16N</u> <u>7W</u> <u>3</u> miles <u>E</u> of <u>Wayside</u> (distance) (direction) (Nearest Town)	<u>Mud</u>		<u>267</u>
	<u>Rock</u>		<u>268</u>
	<u>Mud</u>		<u>279</u>
(3) Topography: <u>Flat</u> (Hilly) (Flat) (Level)	<u>Rock</u>		<u>380</u>
	<u>Mud</u>		<u>410</u>
(4) Purpose of Well: <u>Domestic</u> (Domestic Irrigation Municipal, Industrial, Other)	<u>Sand</u>		<u>440</u>


CODED

Information upon completion of well:

- (1) Diameter 4 x 2 1/2 inches.
- (2) Total Depth 440 feet.
- (3) Water Level 19 feet below top of ground.
- (4) Cased to all way Size 4 x 2 1/2.
- (5) Screen: Size 2 1/2, Length 20 ft.
- (6) Were any formations sealed against pollution?  
no.

**Insuff. info  
to locate**

If YES depth of formation \_\_\_\_\_  
Why \_\_\_\_\_  
Drillers Remarks: \_\_\_\_\_

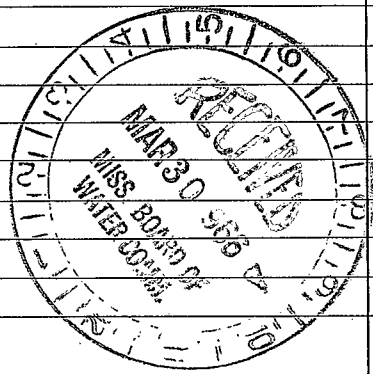

(Use Back Side)

Well No.

