


Washington  
L 47  
4-17-69

MISSISSIPPI  
 BOARD OF WATER COMMISSIONERS  
 416 North State Street  
 Jackson, Mississippi 39201

MODEL

9/13/69  
  
 C2790

WATER WELL DRILLERS LOG

April 17, 1969 Layne-Central Company Washington  
 date well completed firm name county well located


LANDOWNER: Channel Farms, Inc.	description of formations encountered	from	to
	Clay	0	20
	Coarse sand	20	28
Greenville, Mississippi	Coarse sand, pea gravel	28	78
(mailing address)	Coarse sand, pea gravel		
	and gravel	78	90
WELL LOCATION:	Hard pink clay	90	92
sec. <u>8</u> T <u>16</u> N R <u>7</u> E			
5 miles east of Wayside			
(distance) (direction) (nearest town)			
WELL PURPOSE: irrigation			
(home, irrigation, municipal, industrial)			
WELL COMPLETION DATA:			
(1) diameter (inches) 16			
(2) total depth (feet) 92			
(3) static water level (feet) 19' below top of ground.			
(4) casing steel 52' (material) (depth)			
16" (size) if telescope see back.			
(5) screen 40' 92' (length) (depth to top)			
16" Armco (size) (material)			
(6) pump 30 1800 (HP) (yield gpm)			
electric (type power)			
(7) electric log no (yes or no)			
(organization running log)			
(8) how well bottom plugged plate			
DRILLERS REMARKS:			

SEP 19 1969

RECEIVED BY  
 MISSISSIPPI BOARD OF WATER COMMISSIONERS

If well telescopes please  
sketch and show depths.

GROUND LEVEL

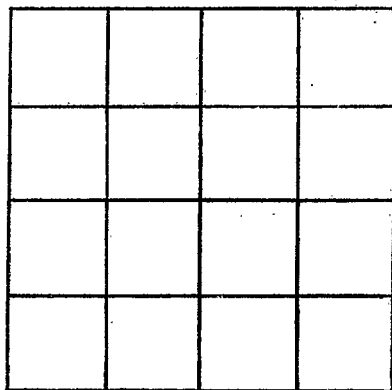

SECTION 8

Please indicate well location X.

ADDITIONAL INFORMATION

If more than one screen,  
show locations of each on sketch.