

Washington

L 50

3-10-70

MISSISSIPPI BOARD OF WATER COMMISSIONERS 416 North State Street Jackson, Mississippi 39201

CODED

WATER WELL DRILLERS LOG

3/10

1970

Bailey Drilling Co

Washington

date well completed

firm name

county well located

LANDOWNER:

Aldridge Brothers - J. N. Aldridge

Areola, Miss.

Description of formations encountered

from

to

(mailing address)

WELL LOCATION:

sec. 24 T 16 N R 7 W

at Estill

(distance) (direction) (nearest town)

WELL PURPOSE:

domestic (home, irrigation, municipal, industrial)

WELL COMPLETION DATA:

(1) diameter (inches) 4 X 3 X 2 1/2

(2) total depth (feet) 1200

(3) static water level (feet) 20 below top of ground.

(4) casing steel (material) (depth)

4 X 3 X 2 1/2 (size) telescope see back.

(5) screen 30' 1170 (length) (depth to top)

2 1/2 Stainless Steel (size) (material)

(6) pump 3 40 (HP) (yield gpm)

Elec (type power)

(7) electric log No (yes or no)

(organization running log)

(8) how well bottom plugged back pressure valve

DRILLERS REMARKS:

MAR 9 1970

MISS. BD. OF WATER COMM.

WATER

Clay	0	20
Sand	20	75
Gravel	75	185
Mud	185	480
Sand	480	548
Mud	548	652
Rock	652	658
Mud	658	700
Sand + Mud	700	870
Rock	870	871
Sand + Mud	871	912
Rock	912	914
Mud	914	920
Sand	920	940
Mud	940	1080
Rock	1081	1081
Mud	1081	1110
Rock	1110	1111
Mud	1111	1120
Sand	1120	1200

If well telescopes please sketch and show depths.


GROUND LEVEL

107' 4"

216' 5"

512' 2 1/2"

50' 2 1/2" Strainer

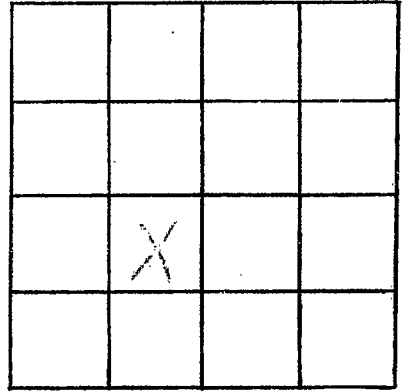

SECTION 11

Please indicate well location X.

ADDITIONAL INFORMATION

If more than one screen, show locations of each on sketch.