

WASHINGTON

L52

7-13-70

MISSISSIPPI BOARD OF WATER COMMISSIONERS
416 North State Street
Jackson, Mississippi 39201

CODED

WATER WELL DRILLERS LOG

7-13

date well completed

19

70 Schultz Drilling & Washington

firm name

county well located

LANDOWNER:

Chalmers Abbott

description of formations encountered

from

to

Oxon, Miss.
(mailing address)

Clay

0 19

Sand

19 23

WELL LOCATION:

sec. 18 T. 16 N. R. 7 E.

Clay

23 202

5 miles S.E. of Wadeside
(distance) (direction) (nearest town)

Sand

202 243

WELL PURPOSE: Home
(home, irrigation, municipal, industrial)

Shale

243 355

WELL COMPLETION DATA:

Rock

355 356

- (1) diameter (inches) 5"
- (2) total depth (feet) 472
- (3) static water level (feet) 23 below top of ground.

Sandy Shale

356 440

Sand

440 485

- (4) casing Galv. (material), (depth) (size) if telescope see back.

- (5) screen 10 (length), (depth to top) 3" STAINLESS (size), (material)

CODED

- (6) pump 1 (HP), 12 (yield gpm) Ele (type power)

- (7) electric log NO (yes or no) (organization running log)


- (8) how well bottom plugged S/S

DRILLERS REMARKS:

SEP 17 1970

If well telescopes please sketch and show depths.

GROUND LEVEL

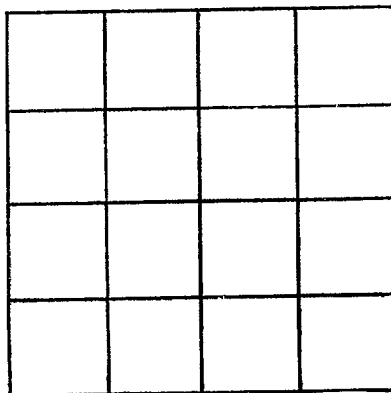

SECTION _____

Please indicate well location X.

ADDITIONAL INFORMATION

If more than one screen, show locations of each on sketch.