

Washington
L 56
6-27-70

MISSISSIPPI
BOARD OF WATER COMMISSIONERS
416 North State Street
Jackson, Mississippi 39201

CODED 7/70
C3210R

WATER WELL DRILLERS LOG

June 27, 1970 Layne-Central Company Washington
date well completed firm name county well located

LANDOWNER: V. C. Hammett, Jr.

Gumboot Farm

Greenville, Mississippi
(mailing address)

WELL LOCATION:

sec. 18 T 16 **N** R 7 **W**

_____ miles _____ of _____
(distance) (direction) (nearest town)

WELL PURPOSE: domestic
(home, irrigation, municipal, industrial)

WELL COMPLETION DATA:

- (1) diameter (inches) 2
- (2) total depth (feet) 402
- (3) static water level (feet) 19' 6" below top of ground.
- (4) casing steel, 379'
(material), (depth),
2" if telescope see back.
(size)
- (5) screen 20', 399'
(length), (depth to top)
2", stainless steel
(size), (material)
- (6) pump 1/3 8
(HP) (yield gpm)
electric
(type power)
- (7) electric log no
(yes or no)

(organization running log)
- (8) how well bottom plugged shot

description of formations encountered

from

to

Clay	0	40
Sand	40	76
Clay	76	109
Rock	109	112
Clay	112	306
Sand, shale strks.	306	400
Shale	400	402

CODED


JUL 23 1970

DRILLERS REMARKS:

MISS. BD. OF
WATER COMM.

If well telescopes please sketch and show depths.

GROUND LEVEL

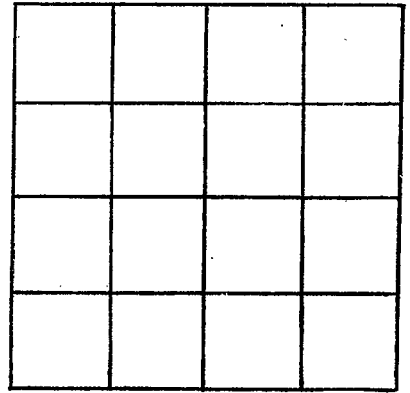

SECTION _____

Please indicate well location X.

ADDITIONAL INFORMATION

If more than one screen,
show locations of each on sketch.