

WASHINGTON
L61
5-12-72

MISSISSIPPI
BOARD OF WATER COMMISSIONERS
416 North State Street
Jackson, Mississippi 39201

CODED

WATER WELL DRILLERS LOG

5-12
date well completed

1972 Schulte Drilling Co
firm name

Washington
county well located

LANDOWNER:	description of formations encountered	from	to
Aldridge Bros Inc Tallendale Miss (mailing address)			
WELL LOCATION: sec <u>24</u> T <u>16</u> (N) R <u>7</u> (W) miles _____ of <u>Be Still</u> (distance) (direction) (nearest town)			
WELL PURPOSE: <u>Drill</u> (home, irrigation, municipal, industrial)			
WELL COMPLETION DATA: (1) diameter (inches) <u>4"</u> (2) total depth (feet) <u>95</u> (3) static water level (feet) <u>14</u> below above top of ground. (4) casing <u>Plastic</u> (material) (depth) _____ if telescope see back. (size) (5) screen <u>20</u> (length) (depth to top) <u>4"</u> <u>Plastic</u> (size) (material) (6) pump <u>3</u> <u>90</u> (HP) (yield gpm) <u>6 hp</u> (type power) (7) electric log <u>no</u> (yes or no) _____ (organization running log) (8) how well bottom plugged <u>plug</u>			
DRILLERS REMARKS:			


CODED

MAY 19 1972

MISS. BD. OF
WATER COMMISSIONERS

If well telescopes please sketch and show depths.

GROUND LEVEL

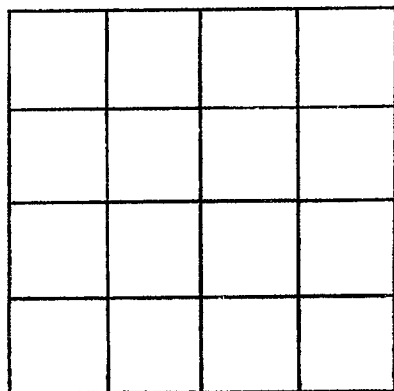

SECTION _____

Please indicate well location X.

ADDITIONAL INFORMATION

A series of horizontal lines for recording additional information.

If more than one screen, show locations of each on sketch.