

WASHINGTON

L 62

8-3-72

MISSISSIPPI BOARD OF WATER COMMISSIONERS  
416 North State Street  
Jackson, Mississippi 39201

**CODED**

WATER WELL DRILLERS LOG

8/3  
date well completed

192 Schultz Drilling  
firm name

Washington  
county well located

LANDOWNER:	description of formations encountered	from	to
Aldrige Bro. Hollendale, Miss (mailing address)			

WELL LOCATION:  
 sec. 24 T. 16 N. R. 7 E  
 miles of Estill  
 (distance) (direction) (nearest town)

WELL PURPOSE: stock  
 (home, irrigation, municipal, industrial)

- WELL COMPLETION DATA:
- (1) diameter (inches) 2"
  - (2) total depth (feet) 65
  - (3) static water level (feet) 15 below top of ground.
  - (4) casing Plastic  
 (material) (depth)
  - (size) if telescope see back.
  - (5) screen 5ft  
 (length) (depth to top)
  - 2"  
 (size) Plastic  
 (material)
  - (6) pump \_\_\_\_\_ (HP) \_\_\_\_\_ (yield gpm)
  - (type power)
  - (7) electric log \_\_\_\_\_ (yes or no)
  - (organization running log)
  - (8) how well bottom plugged Plug


**CODED**

OGI 12 1972

DRILLERS REMARKS:

If well telescopes please sketch and show depths.

GROUND LEVEL

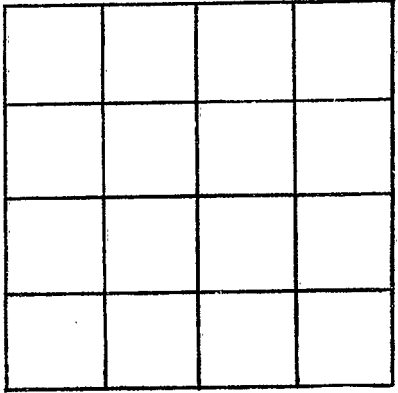

SECTION \_\_\_\_\_

Please indicate well location X.

ADDITIONAL INFORMATION

If more than one screen,  
show locations of each on sketch.