

**CODED**

WASHINGTON  
L 64  
5-30-73

MISSISSIPPI  
BOARD OF WATER COMMISSIONERS  
416 North State Street  
Jackson, Mississippi 39201

**WATER WELL DRILLERS LOG**

5-30 19-73 DYER WELL & IRRIGATION SERVICE WASHINGTON  
date well completed firm name county well located

LANDOWNER: Albert Prewat

HOLLANDALE,

Miss.  
(mailing address)

WELL LOCATION:  
sec. 22 T. 16 N. R. 7 E  
W  
2 1/2 miles E of ESTILL  
(distance) (direction) (nearest town)

WELL PURPOSE: IRR.  
(home, irrigation, municipal, industrial)

**WELL COMPLETION DATA:**

- (1) diameter (inches) 16"
- (2) total depth (feet) 113'
- (3) static water level (feet) 11' below above top of ground.
- (4) casing BLK IR. 73'  
(material) (depth)  
16" if telescopic see back.  
(size)
- (5) screen 40' 73'  
(length) (depth to top)  
16" BLU. I. NGOT  
(size) (material)
- (6) pump 60 2500  
(HP) (yield gpm)  
DIESEL  
(type power)
- (7) electric log No  
(yes or no)

(organization running log)

(8) how well bottom plugged PLATE

description of formations encountered	from	to
<u>Clay</u>	<u>0</u>	<u>18</u>
<u>FINE SAND</u>	<u>18</u>	<u>40</u>
<u>SAND GRAVEL</u>	<u>40</u>	<u>113</u>

**CODED**


JUL 27 1973

DRILLERS REMARKS:

MISS. Bd. OF WATER COMM.

If well telescopes please sketch and show depths.

GROUND LEVEL

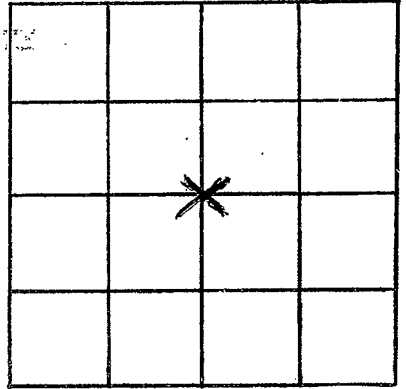

SECTION 22

Please indicate well location X.

ADDITIONAL INFORMATION

If more than one screen, show locations of each on sketch.