

MISSISSIPPI
BOARD OF WATER COMMISSIONERS
416 North State Street
Jackson, Mississippi 39201

WATER WELL DRILLERS LOG

CODED

BOYER WELL & IRRIGATION SERVICE WASHINGTON

WASH.
L 65
7-10-73

7-10 1973 date well completed
BOYER WELL & IRRIGATION SERVICE firm name
WASHINGTON county well located

LANDOWNER: Albert Prewitt

description of formations encountered

from

to

HOLLANDALE,

CLAY

0 23

MISS.

Sand Gravel

23 103

(mailing address)

WELL LOCATION:

sec. 21 T. 16 N. R. 7 E
4 miles NW of ESTILL
(distance) (direction) (nearest town)

WELL PURPOSE: IRRIGATION
(home, irrigation, municipal, industrial)

WELL COMPLETION DATA:

- (1) diameter (inches) 16"
- (2) total depth (feet) 103'
- (3) static water level (feet) 19' below above top of ground.
- (4) casing BUK IN. 63'
(material) (depth)
16" if telescope see back.
(size)
- (5) screen 40' 63'
(length) (depth to top)
16" BUK IN 605
(size) (material)
- (6) pump 60 3000
(HP) (yield gpm)
ELEL
(type power)
- (7) electric log No
(yes or no)

CODED

(organization running log)

(8) how well bottom plugged PLATE


OCT 25 1973

DRILLERS REMARKS:

MISS. DIV. OF
WATER CONTROL

If well telescopes please sketch and show depths.

GROUND LEVEL

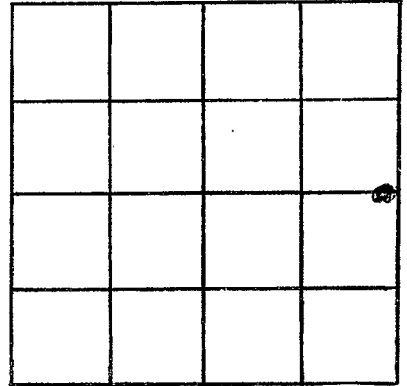

SECTION 21

Please indicate well location X.

ADDITIONAL INFORMATION

If more than one screen,
show locations of each on sketch.