

WASH.  
L66  
4-5-74

MISSISSIPPI  
BOARD OF WATER COMMISSIONERS  
416 North State Street  
Jackson, Mississippi 39201

CODED

WATER WELL DRILLERS LOG  
DYER WELL & IRRIGATION SERVICE

APRIL 5, 1974  
date well completed

firm name

WASHINGTON  
county well located

LANDOWNER:

Virgil SANDIFER

description of formations  
encountered

CLAY

from

to

0 24

HOLLANDALE, MISS.  
(mailing address)

SAND GRAVEL

24 48

LARGE ROCK, PER

48

GRAVEL SAND

103

WELL LOCATION:

sec ~~3~~ <sup>18</sup> T ~~18~~ <sup>20</sup> N R ~~20~~ <sup>20</sup>  
1 miles ~~W~~ <sup>W</sup> of ~~MISSISSIPPI~~ <sup>HOLLANDALE</sup>  
(distance) (direction) (nearest town)

CODED

WELL PURPOSE:


IRR. (home, irrigation, municipal, industrial)

WELL COMPLETION DATA:

- (1) diameter (inches) 12"
- (2) total depth (feet) 103'
- (3) static water level (feet) 15' below above top of ground.
- (4) casing BLK IR. 63'  
(material) (depth)  
12" if telescope see back.  
(size)
- (5) screen 40' 63'  
(length) (depth to top)  
12" BLK INGT  
(size) (material)
- (6) pump 25 1500  
(HP) (yield gpm)  
DIESEL  
(type power)
- (7) electric log No  
(yes or no)

(organization running log)

(8) how well bottom plugged PLATE

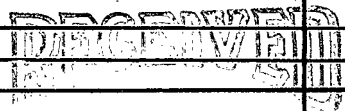


NOV 21 1974

DRILLERS REMARKS:

If well telescopes please sketch and show depths.

GROUND LEVEL

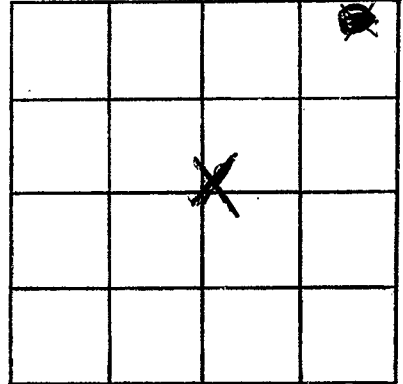

SECTION ~~3~~ /

Please indicate well location X.

ADDITIONAL INFORMATION

If more than one screen,  
show locations of each on sketch.