

WASHINGTON
 L67
 12-10-74

MISSISSIPPI
 BOARD OF WATER COMMISSIONERS
 416 North State Street
 Jackson, Mississippi 39201

CODED

WATER WELL DRILLERS LOG

Dec. 10 1974 Owens by Getty Wash.
 date well completed firm name county well located

LANDOWNER: Earl Wilson
Rt. 2 Box 49
Hollandale, Ms.
 (mailing address)

description of formations encountered	from	to
top soil	0	17
gravel sand	17	106
Clay	106	186
sand + gravel Rocks	186	312
sand	312	459

WELL LOCATION:
 sec. 7 T. 44 N. R. 7 E. 15 J
 7 miles W of R. Hall
 (distance) (direction) (nearest town)

WELL PURPOSE: Home
 (home, irrigation, municipal, industrial)

WELL COMPLETION DATA:

- (1) diameter (inches) 2"
- (2) total depth (feet) 459'
- (3) static water level (feet) 17 below above top of ground.
- (4) casing Galv. 449'
 (material) (depth)
 (size) If telescope see back.
- (5) screen 10' 459'
 (length) (depth to top)
2 SS. - galv.
 (size) (material)
- (6) pump 1 13
 (HP) (yield gpm)
Ctec.
 (type power)
- (7) electric log no
 (yes or no)

(organization running log)

(8) how well bottom plugged O.S.B.

DRILLERS REMARKS: Owens


CODED

RECEIVED
 JAN 8 1975

MISS. BD. OF WATER COMMISSIONERS

If well telescopes please sketch and show depths.

GROUND LEVEL

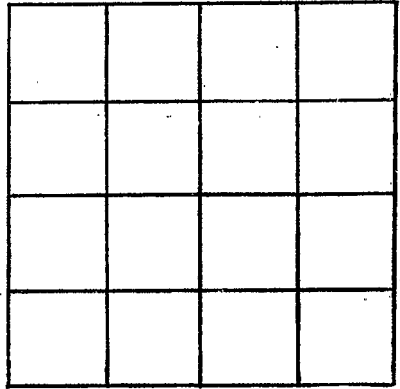

SECTION _____

Please indicate well location X.

ADDITIONAL INFORMATION

If more than one screen, show locations of each on sketch.