

WASH.
 L 69
 2-20-76

MISSISSIPPI
 BOARD OF WATER COMMISSIONERS
 416 North State Street
 Jackson, Mississippi 39201

Coded
 1005

WATER WELL DRILLERS LOG

2-20 1976 Dyer-Julliam WASHINGTON
 date well completed firm name county well located

LANDOWNER: F. C. Land Co.

ESTILL, MISS

(mailing address)

description of formations encountered

from

to

CLAY

0 14

FINE SAND & CLAY

14 37

SAND

31 52

SAND & GRAVEL

52 111

WELL LOCATION:

sec. 3 T. 16 N R. 2 W
6 W

4 miles NORTH of ESTILL
 (distance) (direction) (nearest town)

WELL PURPOSE: FIND WATER
 (home, irrigation, municipal, industrial)

WELL COMPLETION DATA:

(1) diameter (inches) 16"

(2) total depth (feet) 111'

(3) static water level (feet) 12' below
top of ground. above

(4) casing Steel, 71'
(material) (depth)

16" if telescope see back.
(size)

(5) screen 40', 71'
(length) (depth to top)

16", Steel
(size) (material)


(6) pump 50, 2300
(HP) (yield gpm)

BUTANE
(type power)

(7) electric log NO
(yes or no)

(organization running log)

(8) how well bottom plugged PLATE

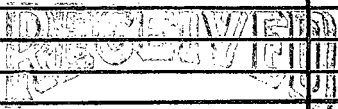


MAR 11 1976

DRILLERS REMARKS:

MISS. BD. OF WATER COMMISSIONERS

If well telescopes please sketch and show depths.

GROUND LEVEL

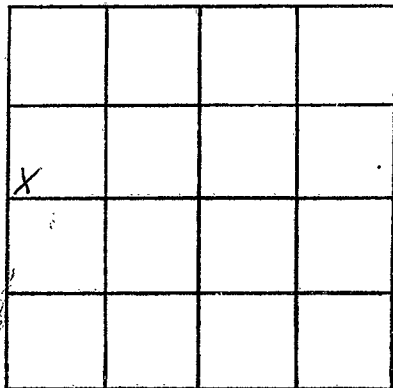

SECTION _____

Please indicate well location X.

ADDITIONAL INFORMATION

If more than one screen,
show locations of each on sketch.