

WASH.
L 71
2-15-77

**MISSISSIPPI
BOARD OF WATER COMMISSIONERS**

416 North State Street
Jackson, Mississippi 39201

WATER WELL DRILLERS LOG

DYER-SULLIVAN, INC.

2-15

1977

date well completed

firm name

Washington
county well located

LANDOWNER: *4C Land Co.*

ESTILL, MISS.

(mailing address)

WELL LOCATION:

sec. *23* T. *16* N R. *2* E
S W
2 miles *SW* of *ESTILL*
(distance) (direction) (nearest town)

WELL PURPOSE: *1st*
(home, irrigation, municipal, industrial)

WELL COMPLETION DATA:

- (1) diameter (inches) *16"*
- (2) total depth (feet) *110'*
- (3) static water level (feet) *16* below
top of ground. above
- (4) casing *Steel*, *70'*
(material) (depth)
16"
(size) if telescope see back.
- (5) screen *40'*, *70'*
(length) (depth to top)
16", *Steel*
(size) (material)
- (6) pump *50* *2500*
(HP) (yield gpm)
Diesel
(type power)
- (7) electric log *NO*
(yes or no)

(organization running log)

(8) how well bottom plugged *PLATE*

DRILLERS REMARKS:

description of formations
encountered

from

to

CLAY

0

10

FINE SAND

10

31

COARSE SAND & GRAVEL

31

110

CLAY

110


CODED

RECEIVED
MAR 18 1977

MISS. BD. OF WATER COM.

If well telescopes please
sketch and show depths.

GROUND LEVEL

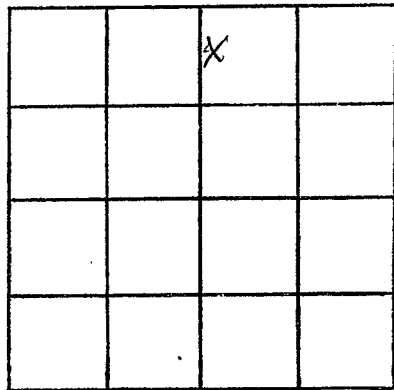

SECTION _____

Please indicate well location X.

ADDITIONAL INFORMATION

If more than one screen,
show locations of each on sketch.