

WASHINGTON  
L73  
3-15-19

MISSISSIPPI  
BOARD OF WATER COMMISSIONERS  
416 North State Street  
Jackson, Mississippi 39201

CODED

WATER WELL DRILLERS LOG

3-15-19 79 Larry's Well Pump Co. Washington Co.  
date well completed firm name county well located

LANDOWNER: <u>Buddy Cochran</u>	description of formations encountered	from	to
(mailing address)	clay	0	20'
WELL LOCATION:	clay & fine sand	20	35'
sec. <u>29</u> T <u>16</u> (N) S R <u>7</u> E W of <u>Estill</u> (distance) (direction) (nearest town)	fine sand	35	45'
WELL PURPOSE: (home, irrigation, municipal, industrial)	med + coarse sand (y)	45	55'
WELL COMPLETION DATA:	coarse sand (y)	55	105'
(1) diameter (inches) <u>12"</u>			
(2) total depth (feet) <u>105</u>			
(3) static water level (feet) <u>21</u> below above top of ground.			
(4) casing <u>steel</u> , <u>65'</u> (material) (depth)  If telescope see back. (size)			
(5) screen <u>40</u> , <u>65'</u> (length) (depth to top)			
<u>12"</u> , <u>steel</u> (size) (material)			
(6) pump <u>30</u> , <u>2000</u> (HP) (yield gpm)			
<u>0</u> (type power)			
(7) electric log <u>no</u> (yes or no)			
(organization running log)			
(8) how well bottom plugged <u>steel plate</u>			
DRILLERS REMARKS:			


Miss. Board of Water Comm.

AUG 21 1979

RECEIVED

If well telescopes please sketch and show depths.

GROUND LEVEL

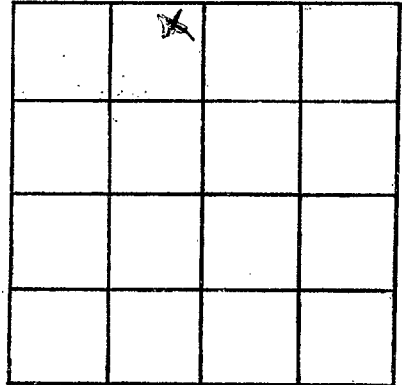

SECTION 29

Please indicate well location X.

ADDITIONAL INFORMATION

If more than one screen,  
show locations of each on sketch.