

WASHINGTON
L 74
7-24-79

MISSISSIPPI
BOARD OF WATER COMMISSIONERS
416 North State Street
Jackson, Mississippi 39201

CODED

WATER WELL DRILLERS LOG

7-24 1979
date well completed

79 Larry Well Bump Washington
firm name county well located

LANDOWNER: WC Skates

description of formations encountered

from to

Arcola Miss

(mailing address)

WELL LOCATION:

sec. 8 T 16 N R 7 E W
4 West miles 1 South of Arcola
(distance) (direction) (nearest town)

slay	0	27
fine sand	27	42
med sand	42	67
course sand	67	77
coarse sand/gravel	77	84

CODED

WELL PURPOSE:

(home, irrigation, municipal, industrial)

WELL COMPLETION DATA:

- (1) diameter (inches) 16"
- (2) total depth (feet) 85'
- (3) static water level (feet) 22 ^{below}/_{above} top of ground.
- (4) casing steel 55'
(material) (depth)
(size) if telescope see back.
- (5) screen 30' 55'
(length) (depth to top)
16" steel
(size) (material)
- (6) pump 20 1000
(HP) (yield gpm)
Electric
(type power)
- (7) electric log _____
(yes or no)

(organization running log)

- (8) how well bottom plugged steel plate

DRILLERS REMARKS:


Miss. Board of Water Comm

AUG 21 1979

RECEIVED

If well telescopes please sketch and show depths.

GROUND LEVEL

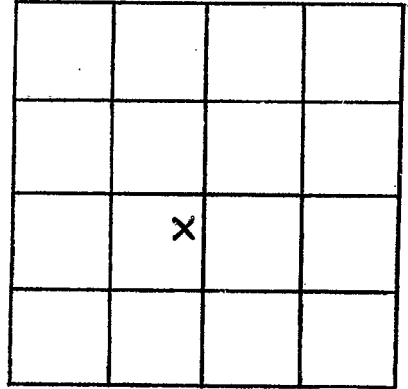

SECTION 8

Please indicate well location X.

ADDITIONAL INFORMATION

If more than one screen,
show locations of each on sketch.