

MISSISSIPPI DEPARTMENT OF NATURAL RESOURCES

Bureau of Land and Water Resources

Southport Mall

P.O. Box 10631

Jackson, Mississippi 39209

CODED

WATER WELL DRILLERS LOG

WASHINGTON  
L 80  
5-29-81

29 May 1981 Coppage Drilling Inc Washington  
date well completed firm name county well located

LANDOWNER: Sidney Kabin description of formations encountered from to

Oricola MS (mailing address) Humbo-clay 0' 25'  
Sand 25' 80'  
Gravel 80' 120'  
Mud 120' 380'  
Sand 380' 440'

WELL LOCATION:  
sec. 2 T. 16 N. R. 2 E  
? 5 miles SW of Estill  
(distance) (direction) (nearest town)


WELL PURPOSE:  
(home, irrigation, municipal, industrial)

- WELL COMPLETION DATA:
- (1) diameter (inches) 4" - 2"
  - (2) total depth (feet) 440'
  - (3) static water level (feet) 47' below above top of ground.
  - (4) casing PVC, 395'  
(material) (depth)  
4"-2" if telescope see back.  
(size)
  - (5) screen 15', 395'  
(length) (depth to top)  
2", #10 slot PVC  
(size) (material)
  - (6) pump 1 1/2, 30  
(HP) (yield gpm)  
Elec Submersible  
(type power)
  - (7) electric log N/A  
(yes or no)

(organization running log)


(8) how well bottom plugged 2" Brass Back Wash Valve

DRILLERS REMARKS:  
w/220 gallon tank

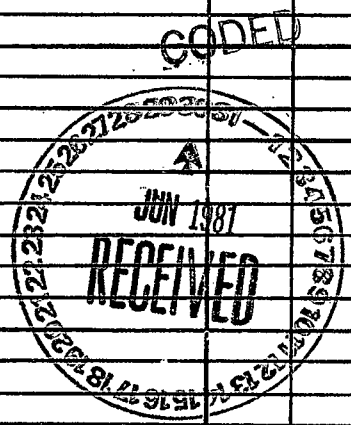

If well telescopes please sketch and show depths.

GROUND LEVEL

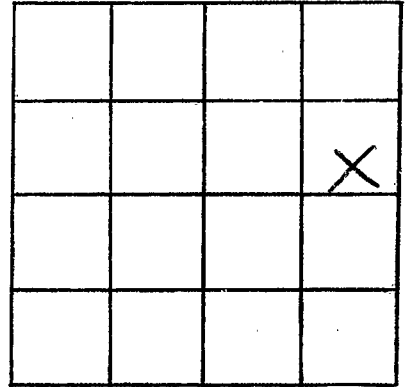

SECTION \_\_\_\_\_

Please indicate well location X.

ADDITIONAL INFORMATION

160' - 4" PVC  
233' - 2" PVC

If more than one screen, show locations of each on sketch.