

WASHINGTON
SOURCE
L 86
10/30/82

MISSISSIPPI DEPARTMENT OF NATURAL RESOURCES

Bureau of Land and Water Resources

Southport Mall

P.O. Box 10631

Jackson, Mississippi 39209

WATER WELL DRILLERS LOG

TOM GRIFFITH

PLUMBING & WELL SERVICE, INC.
firm name

Washington

10/30/82
date well completed

Washington
county well located

LANDOWNER:

Newt Hughes Drilling Co.

Lease - Rush Nail Lake #1
(mailing address)

description of formations encountered

from

to

Gumbo
Sand

0 19
19 180

WELL LOCATION:

sec. 22 T 16 N R 7 E
S W
5 miles NW of Hollandal
(distance) (direction) (nearest town)

WELL PURPOSE: *Oil location*
(home, irrigation, municipal, industrial)

905' N & 18 39' W of
SE 1/4

WELL COMPLETION DATA:

- (1) diameter (inches) 3"
- (2) total depth (feet) 180'
- (3) static water level (feet) 20' below top of ground.
- (4) casing *Steel TC* 140' (material) (depth)
- N/A* (size) if telescope see back.
- (5) screen 40' 140' (length) (depth to top)
- 3" *Steel slots* (size) (material)
- (6) pump *None* 80 (HP) (yield gpm)
- Electric Air Lift* (type power)

CODED

- (7) electric log *none* (yes or no)
- N/A* (organization running log)

- (8) how well bottom plugged *welded*
plugged

DRILLERS REMARKS:


DEPT. OF NATURAL RESOURCES
BUREAU OF LAND & WATER RESOURCES

JAN 28 1983

RECEIVED

If well telescopes please sketch and show depths.

GROUND LEVEL

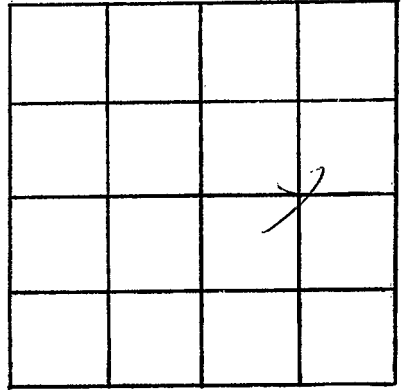

SECTION 22

Please indicate well location X.

ADDITIONAL INFORMATION

If more than one screen,
show locations of each on sketch.