

MISSISSIPPI DEPARTMENT OF NATURAL RESOURCES

Bureau of Land and Water Resources

Southport Mall

P.O. Box 10631

Jackson, Mississippi 39209

WATER WELL DRILLERS LOG

CODED

Washington
 L 87
 5714182

14 May 1982 date well completed
 Coppage Drilling Inc firm name
 Washington county well located

LANDOWNER: Joe Trotter
 P.O. Box
 Areola MS
 (mailing address)

WELL LOCATION:
 sec. 2 T. 16 N. R. 7 W.
 2 miles west of Areola
 (distance) (direction) (nearest town)

WELL PURPOSE: Irrigation
 (home, irrigation, municipal, industrial)

WELL COMPLETION DATA:

- (1) diameter (inches) 16" 3/8" R
- (2) total depth (feet) 100'
- (3) static water level (feet) 27' below top of ground.
- (4) casing Steel 16" x 60'
 (material) (depth)
 16" (size) if telescope see back.
- (5) screen 40' - 60'
 (length) (depth to top)
 16, 12% Steel
 (size) (material)
- (6) pump 60 2000
 (HP) (yield gpm)
 Diesel
 (type power)
- (7) electric log None
 (yes or no)
 None
 (organization running log)
- (8) how well bottom plugged Plate
 welded on

description of formations encountered	from	to
Clay	0	15
clay & sand	15	20
fine sand & clay	20	30
Coarse sand	30	38
Pea gravel & sand	38	45
Gravel	45	55
Sand	55	60
Coarse sand	60	65
Gravel	65	105

CODED


DEPT. OF NATURAL RESOURCES
 BUREAU OF LAND & WATER RESOURCES

MAY 26 1982
 RECEIVED

DRILLERS REMARKS:

If well telescopes please sketch and show depths.

GROUND LEVEL

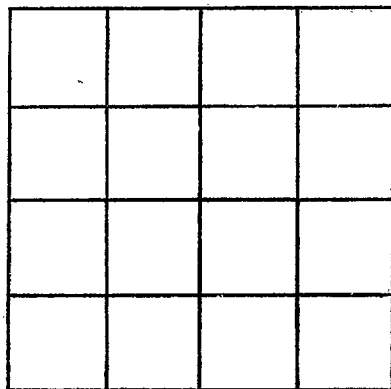

SECTION _____

Please indicate well location X.

ADDITIONAL INFORMATION

If more than one screen, show locations of each on sketch: