

MISSISSIPPI DEPARTMENT OF NATURAL RESOURCES

Bureau of Land and Water Resources

Southport Mall

P.O. Box 10631

Jackson, Mississippi 39209

WATER WELL DRILLERS LOG

CODED

Washington  
L 88  
7/20/82

July 20 1982 date well completed  
Larvin's well v pump firm name  
Washington Co. county well located

LANDOWNER: <u>W.C. Skates</u>	description of formations encountered	from	to
<u>Avon Mississippi</u> (mailing address)	<u>clay</u>	<u>0</u>	<u>20'</u>
WELL LOCATION:	<u>fine sand</u>	<u>20</u>	<u>30'</u>
sec. <u>9</u> T <u>16</u> N R <u>7</u> E S W	<u>med sand</u>	<u>30</u>	<u>60'</u>
<u>3</u> west miles <u>15</u> of <u>Avon</u> (distance) (direction) (nearest town)	<u>course sand &amp; gravel</u>	<u>60</u>	<u>116'</u>
WELL PURPOSE: <u>fish pond</u> (home, irrigation, municipal, industrial)			
WELL COMPLETION DATA:			
(1) diameter (inches) <u>16"</u>			
(2) total depth (feet) <u>116'</u>			
(3) static water level (feet) <u>24'</u> below above top of ground.			
(4) casing <u>Steel</u> , <u>76'</u> (material) (depth)			
(size) if telescope see back.			
(5) screen <u>40'</u> , <u>76'</u> (length) (depth to top)			
<u>16"</u> , <u>Steel</u> (size) (material)			
(6) pump <u>60</u> , <u>2500</u> (HP) (yield gpm)			
<u>Elec.</u> (type power)			
(7) electric log <u>NO</u> (yes or no)			
(organization running log)			
(8) how well bottom plugged <u>Steel Plate</u>			
DRILLERS REMARKS:			

CODED


DEPT. OF NATURAL RESOURCES  
BUREAU OF LAND & WATER RESOURCES

SEP 20 1982

RECEIVED

If well telescopes please sketch and show depths.

GROUND LEVEL

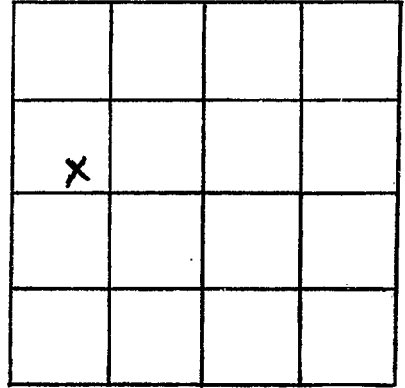

SECTION 9

Please indicate well location X.

ADDITIONAL INFORMATION

If more than one screen,  
show locations of each on sketch.