

WASHINGTON
 L ~~2~~ 89
 6-13-77

MISSISSIPPI
 BOARD OF WATER COMMISSIONERS
 416 North State Street
 Jackson, Mississippi 39201
 WATER WELL DRILLERS LOG

CODED

6-13 19 77 Layne Central Co. Washington
 date well completed firm name county well located

LANDOWNER:	description of formations encountered	from	to
Longwood Farms	Clay	0	27
ARcola, MS	fine sand	27	35
(mailing address)	med. coarse sand	35	49
WELL LOCATION:	coarse sand & gravel	49	76
sec. 7 T. 16 N R. 8 ⁷ W	clay	76	77
5 miles SE of Wayside			
(distance) (direction) (nearest town)			
WELL PURPOSE: Irrigation			
(home, irrigation, municipal, industrial)			
WELL COMPLETION DATA:			
(1) diameter (inches) 12"			
(2) total depth (feet) 76'			
(3) static water level (feet) 22 below top of ground.			
(4) casing Steel 50'			
(material) (depth)			
12" (size) if telescope see back.			
(5) screen 26' 50'			
(length) (depth to top)			
10" St. Steel			
(size) (material)			
(6) pump 20 1,000			
(HP) (yield gpm)			
diesel			
(type power)			
(7) electric log No			
(yes or no)			
(organization running log)			
(8) how well bottom plugged St. Plate			
DRILLERS REMARKS:			


CODED

RECEIVED
 SEP 12 1977

MISS. DEP. OF WATER CONTROL

If well telescopes please sketch and show depths.

GROUND LEVEL

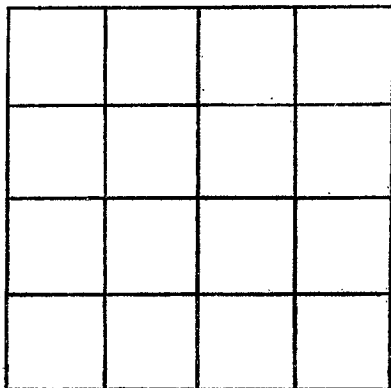

SECTION _____

Please indicate well location X.

ADDITIONAL INFORMATION

If more than one screen, show locations of each on sketch.