

MISSISSIPPI DEPARTMENT OF NATURAL RESOURCES

Bureau of Land and Water Resources

Southport Mall

P.O. Box 10631

Jackson, Mississippi 39209

WATER WELL DRILLERS LOG

CODED

WASHINGTON
L 90
8-26-83

Aug. 26 1983
date well completed

Larry's well pump
firm name

Washington
county well located

LANDOWNER:

Virgil Santifer

description of formations encountered

from

to

Holladay, Mo
(mailing address)

slay	0	30
fine sand	30	50
coarse sand & gravel	50	116

WELL LOCATION:

SW NW

sec. 36 T 16 N R 7 E
S W

1/2 miles west of Holladay
(distance) (direction) (nearest town)

CODED

WELL PURPOSE:

(home, irrigation, municipal, industrial)

WELL COMPLETION DATA:

- (1) diameter (inches) 16"
- (2) total depth (feet) 116'
- (3) static water level (feet) 22' below top of ground.
- (4) casing Steel, 76' (material) (depth)
(size) if telescope see back.
- (5) screen 40' length, 76' depth to top, 16" size, Steel material
- (6) pump 30 HP, 1500 yield gpm, Electric type power
- (7) electric log No (yes or no)

(organization running log)

(8) how well bottom plugged Steel Plate

DRILLERS REMARKS:


DEPT. OF NATURAL RESOURCES
BUREAU OF LAND & WATER RESOURCES

FEB 15 1984

RECEIVED

If well telescopes please sketch and show depths.

GROUND LEVEL

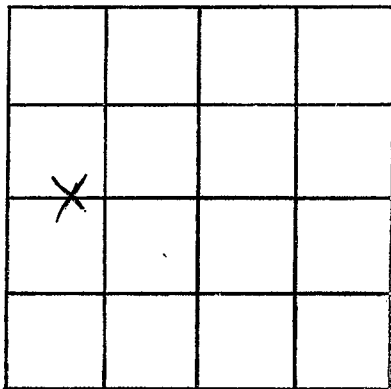

SECTION 36

Please indicate well location X.

ADDITIONAL INFORMATION

If more than one screen,
show locations of each on sketch.