

MISSISSIPPI DEPARTMENT OF NATURAL RESOURCES

Bureau of Land and Water Resources

Southport Mall

P.O. Box 10631

Jackson, Mississippi 39209

WATER WELL DRILLERS LOG

292
Well #1
WASHINGTON
5-15-84

CODED

1984 Schultz Drilling Washington
date well completed firm name county well located

| LANDOWNER: | description of formations encountered | from | to |
|---|---------------------------------------|------|----|
| Chalmers Hobart Avon MS (mailing address) | | | |
| WELL LOCATION: sec. 19 T 16 S R 7 E 3 miles SW of Arcola (distance) (direction) (nearest town) | | | |
| WELL PURPOSE: IRRIGATION (home, irrigation, municipal, industrial) | | | |
| WELL COMPLETION DATA: | | | |
| (1) diameter (inches) 10" | | | |
| (2) total depth (feet) 80' | | | |
| (3) static water level (feet) 21' below top of ground. | | | |
| (4) casing PVC 60' (material) (depth) | | | |
| (size) if telescope see back. | | | |
| (5) screen 20' 60' (length) (depth to top) | | | |
| 10" PVC (size) (material) | | | |
| (6) pump 7 1/2 600 (HP) (yield gpm) | | | |
| ele (type power) | | | |
| (7) electric log NO (yes or no) | | | |
| X (organization running log) | | | |
| (8) how well bottom plugged PVC CAP | | | |

DEPT. OF NATURAL RESOURCES
BUREAU OF LAND & WATER RESOURCES


MAY 21 1984

RECEIVED

DRILLERS REMARKS:

If well telescopes please sketch and show depths.

GROUND LEVEL

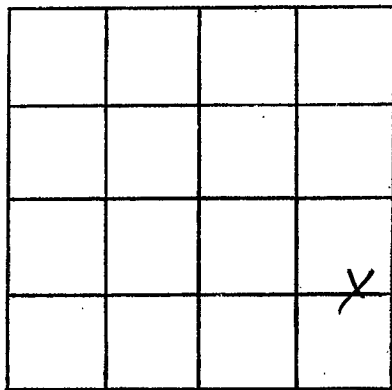

SECTION 19

Please indicate well location X.

ADDITIONAL INFORMATION

If more than one screen,
show locations of each on sketch.