

MISSISSIPPI DEPARTMENT OF NATURAL RESOURCES

Bureau of Land and Water Resources

Southport Mall

P.O. Box 10631

Jackson, Mississippi 39209

WATER WELL DRILLERS LOG

L93
well #2
WASHINGTON
5-16-84
5-16-1984

CODED

Schultz Drilling WASHINGTON

date well completed

firm name

county well located

LANDOWNER:	description of formations encountered	from	to
Chalmers Hobart	Clay	0	50
Avon, MS	COARSE SAND	50	60
(mailing address)	COARSE SAND	60	80
	+ pea gravel		
WELL LOCATION:			
sec. 19 T. 16 N. R. 7 E.			
3 miles SW of Arcola			
(distance) (direction) (nearest town)			
WELL PURPOSE: IRRIGATION			
(home, irrigation, municipal, industrial)			
WELL COMPLETION DATA:			
(1) diameter (inches) 10"			
(2) total depth (feet) 80'			
(3) static water level (feet) 21' below top of ground.			
(4) casing PVC 60' (material) (depth)			
(size) if telescope see back.			
(5) screen 20' 60' (length) (depth to top)			
10" PVC (size) (material)			
(6) pump 7 1/2 600 (HP) (yield gpm)			
ele (type power)			
(7) electric log NO (yes or no)			
X (organization running log)			
(8) how well bottom plugged PVC CAP			


DEPT. OF NATURAL RESOURCES
BUREAU OF LAND & WATER RESOURCES

MAY 21 1984
RECEIVED

DRILLERS REMARKS:

If well telescopes please sketch and show depths.

GROUND LEVEL

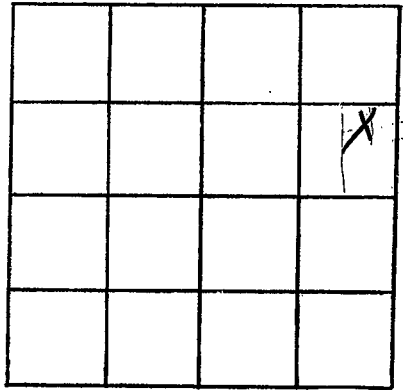

SECTION 19

Please indicate well location X.

ADDITIONAL INFORMATION

If more than one screen,
show locations of each on sketch.