

MISSISSIPPI DEPARTMENT OF NATURAL RESOURCES
Bureau of Land and Water Resources
 Southport Mall
 P.O. Box 10631
 Jackson, Mississippi 39209
WATER WELL DRILLERS LOG

CODED

WASHINGTON
CL-3101
LOA

8/8 1985 LAYNE-CENTRAL WASHINGTON
 date well completed firm name county well located

LANDOWNER:	description of formations encountered	from	to
RAYBUN JONES			
P.O. Drawer 560	coarse sand	24	40
Greenville, MS 38701	coarse sand gravel	40	70
(mailing address)	gravel	70	122

WELL LOCATION:
 sec. 25 T 16 N R 7 W
3 miles N of Hollandale
 (distance) (direction) (nearest town)

WELL PURPOSE: irrigation
 (home, irrigation, municipal, industrial)

- WELL COMPLETION DATA:**
- (1) diameter (inches) 16"
 - (2) total depth (feet) 123'
 - (3) static water level (feet) _____ below/above top of ground.
 - (4) casing steel 73'
 (material) (depth)
16" if telescope see back.
 (size)
 - (5) screen 50' 73'
 (length) (depth to top)
16" steel
 (size) (material)
 - (6) pump none _____
 (HP) (yield gpm)
 (type power)
 - (7) electric log no
 (yes or no)
 (organization running log)
 - (8) how well bottom plugged plate


RECEIVED
 NOV 14 1985

DRILLERS REMARKS: _____

Department of Natural Resources
 Bureau of Land & Water Resources

If well telescopes please sketch and show depths.

GROUND LEVEL

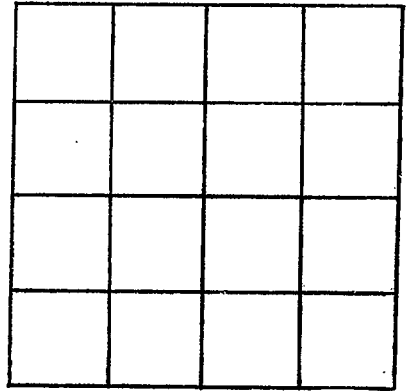

SECTION _____

Please indicate well location X.

ADDITIONAL INFORMATION

A series of horizontal lines providing space for additional information.

If more than one screen, show locations of each on sketch.