

MISSISSIPPI DEPARTMENT OF NATURAL RESOURCES

Bureau of Land and Water Resources

Southport Mall

P.O. Box 10631

Jackson, Mississippi 39209

WATER WELL DRILLERS LOG

CODED

WASHINGTON
L 95

8-20-85 date well completed Schultz Drilling firm name WASH county well located

LANDOWNER: FARM Fresh Catfish
Greenville, MS
(mailing address)

description of formations encountered	from	to
CLAY	0	20'
SAND	30	80'

WELL LOCATION: sec. 19 T 10 S R 7 E W
(distance) miles (direction) of (nearest town)

WELL PURPOSE: IRRIGATION
(home, irrigation, municipal, industrial)

- WELL COMPLETION DATA:
- (1) diameter (inches) 10"
 - (2) total depth (feet) 80'
 - (3) static water level (feet) 38' below top of ground.
 - (4) casing PVC 60' (material) (depth)
 - (size) If telescope see back.
 - (5) screen 20' 60' (length) (depth to top)
10" PVC (size) (material)
 - (6) pump 20 1000 (HP) (yield gpm)
ele (type power)
 - (7) electric log NO (yes or no)
X (organization running log)
 - (8) how well bottom plugged CAP

CODED

RECEIVED

DEC 3 - 1985


Department of Natural Resources
Bureau of Land & Water Resources

DRILLERS REMARKS:

If well telescopes please sketch and show depths.

GROUND LEVEL

03000

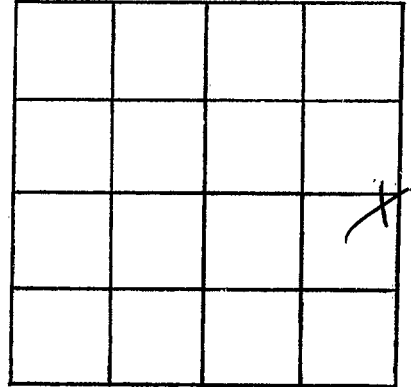

SECTION

19

Please indicate well location X.

ADDITIONAL INFORMATION

If more than one screen,
show locations of each on sketch.