

Washington
L 96
0210

MISSISSIPPI DEPARTMENT OF NATURAL RESOURCES
Bureau of Land and Water Resources
Southport Mall
P.O. Box 10631
Jackson, Mississippi 39209
WATER WELL DRILLERS LOG

CODED

5-27-87 date well completed
Schultz Drilling firm name
Washington county well located

LANDOWNER:
FARM Fresh Catfish
Holladale MS.
(mailing address)

description of formations encountered	from	to
	CLAY	0
Coarse SAND	30	50
SAND + gravel	50	78

WELL LOCATION:
sec. 19 T. 16 N. R. 7 E.
3 1/2 miles SW of Arcola
(distance) (direction) (nearest town)

WELL PURPOSE: IRRIGATION
(home, irrigation, municipal, industrial)

- WELL COMPLETION DATA:
- (1) diameter (inches) 10"
 - (2) total depth (feet) 78'
 - (3) static water level (feet) 33' below top of ground.
 - (4) casing PUC, 68' (material), (depth)
(size) if telescope see back.
 - (5) screen 20' 68' (length), (depth to top)
10" PUC (size), (material)
 - (6) pump 15 750 (HP), (yield gpm)
ele. (type power)
 - (7) electric log NO (yes or no)
(organization running log) X
 - (8) how well bottom plugged CAP

DRILLERS REMARKS:

CODED


RECEIVED

JUL 3 1987

Department of Natural Resources
Bureau of Land & Water Resources

If well telescopes please sketch and show depths.

GROUND LEVEL

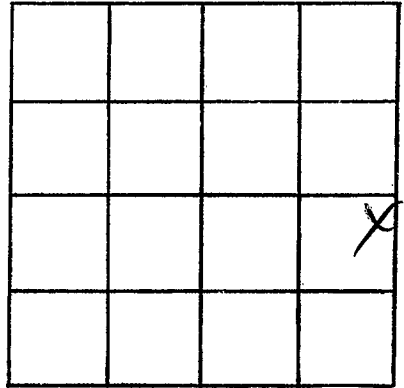

SECTION 19

Please indicate well location X.

ADDITIONAL INFORMATION

If more than one screen,
show locations of each on sketch.