

MISSISSIPPI DEPARTMENT OF NATURAL RESOURCES

Bureau of Land and Water Resources

Southport Mall

P.O. Box 10631

Jackson, Mississippi 39209

WATER WELL DRILLERS LOG

Washington
L 97
166 A

Caded

①

10-14 1987 J&K Irrigation Washington
 date well completed firm name county well located

LANDOWNER: Paul Smith
Moorehead, Miss
 (mailing address)

description of formations encountered	from	to
<u>Clay</u>	<u>0</u>	<u>18</u>
<u>Fine Sand</u>	<u>18</u>	<u>32</u>
<u>Coar Sand & Gravel</u>	<u>32</u>	<u>107</u>

WELL LOCATION:
 sec. 31 T. 16 N R. 7 E
3 miles W of Holland
 (distance) (direction) (nearest town)

WELL PURPOSE: Fish
 (home, irrigation, municipal, industrial)

WELL COMPLETION DATA:

(1) diameter (inches) 16"

(2) total depth (feet) 107

(3) static water level (feet) 19 below above top of ground.

(4) casing Steel 77
 (material) (depth)
16" if telescope see back.
 (size)

(5) screen 40 77'
 (length) (depth to top)
16" Steel
 (size) (material)

(6) pump 50 2400
 (HP) (yield gpm)
Electric
 (type power)

(7) electric log no
 (yes or no)
 (organization running log)

(8) how well bottom plugged plate


RECEIVED
 NOV 12 1987

DRILLERS REMARKS:

Department of Natural Resources
 Bureau of Land & Water Resources

If well telescopes please sketch and show depths.

GROUND LEVEL

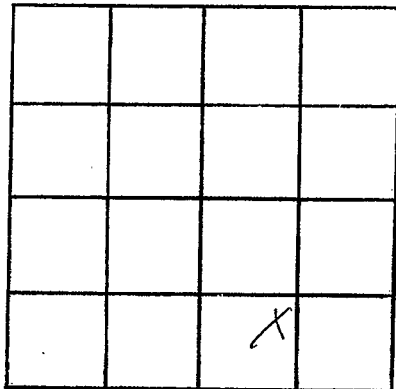

SECTION 31

Please indicate well location X.

ADDITIONAL INFORMATION

If more than one screen,
show locations of each on sketch.