

MISSISSIPPI DEPARTMENT OF NATURAL RESOURCES

Bureau of Land and Water Resources

Southport Mall

P.O. Box 10631

Jackson, Mississippi 39209

WATER WELL DRILLERS LOG

Washington
L 98
166 A

Coded

10-18 1987 J & K Integration Washington
 date well completed firm name county well located

LANDOWNER: PAUL SMITH
MOOREHEAD, MISS
 (mailing address)

| description of formations encountered | from | to |
|---------------------------------------|------|----|
| Clay | 0 | 14 |
| Fine Sand | 14 | 31 |
| Co. Sand & Gravel | 31 | 92 |

WELL LOCATION:
 sec. 20 T. 16 N. R. 7 E
4 miles W of ABERATI
 (distance) (direction) (nearest town)

WELL PURPOSE: Fish
 (home, irrigation, municipal, industrial)

WELL COMPLETION DATA:

(1) diameter (inches) 16"

(2) total depth (feet) 92'

(3) static water level (feet) 19 below/above top of ground.


(4) casing Steel / 52
 (material) (depth)
16" if telescope see back.
 (size)

(5) screen 40' / 52
 (length) (depth to top)
16" / Steel
 (size) (material)

(6) pump 30 / 1500
 (HP) (yield gpm)
Electric
 (type power)

(7) electric log NO
 (yes or no)
 (organization running log)

(8) how well bottom plugged Plate

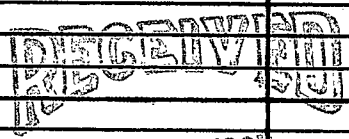


NOV 12 1987

Department of Natural Resources
 Bureau of Land & Water Resources

DRILLERS REMARKS:

If well telescopes please
sketch and show depths.

GROUND LEVEL

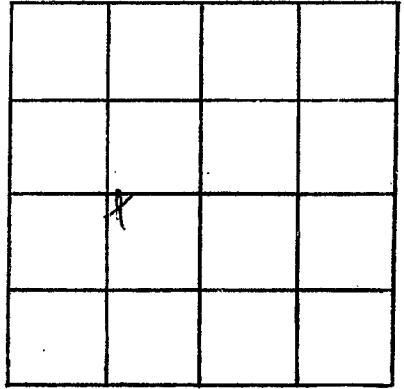

SECTION 20

Please indicate well location X.

ADDITIONAL INFORMATION

If more than one screen,
show locations of each on sketch.