

MISSISSIPPI DEPARTMENT OF NATURAL RESOURCES

Bureau of Land and Water Resources

Southport Mall

P.O. Box 10631

Jackson, Mississippi 39209

WATER WELL DRILLERS LOG

WASHINGTON
L 99
166 A

Coded

1023 1987 J & K IRRIGATION WASHINGTON  
 date well completed firm name county well located

LANDOWNER: PAUL SMITH  
 MOOREHEAD, MISS  
 (mailing address)

description of formations encountered	from	to
CLAY	0	13
FINE SAND	13	27
C. SAND & GRAVEL	27	87

WELL LOCATION:  
 sec. 20 T. 16 N. R. 7 E  
 4 1/2 miles W of ESTILL  
 (distance) (direction) (nearest town)

WELL PURPOSE: Fish  
 (home, irrigation, municipal, industrial)

WELL COMPLETION DATA:

(1) diameter (inches) 16"

(2) total depth (feet) 87'

(3) static water level (feet) 19' below top of ground

(4) casing Steel 47' (material) (depth)  
 16" (size) if telescope see back.

(5) screen 40' 47' (length) (depth to top)  
 16" Steel (size) (material)

(6) pump 30 1500 (HP) (yield gpm)  
 Electric (type power)

(7) electric log NO (yes or no)  
 (organization running log)

(8) how well bottom plugged PLATE

RECEIVED  
 RECEIVED


NOV 12 1987

Department of Natural Resources  
 Bureau of Land & Water Resources

DRILLERS REMARKS:

If well telescopes please sketch and show depths.

GROUND LEVEL

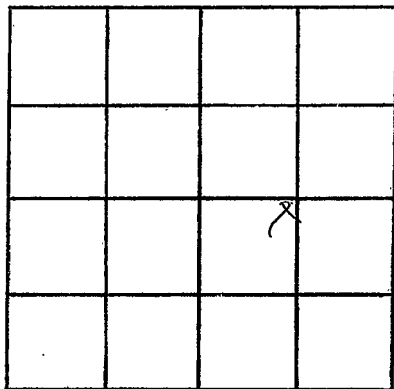

SECTION \_\_\_\_\_

Please indicate well location X.

ADDITIONAL INFORMATION

If more than one screen,  
show locations of each on sketch.