

MISSISSIPPI DEPARTMENT OF NATURAL RESOURCES

Bureau of Land and Water Resources

Southport Mall

P.O. Box 10631

Jackson, Mississippi 39209

WATER WELL DRILLERS LOG

Washington  
100  
166A

Coded

2-25 1988  
 date well completed

Scholtz Drilling  
 firm name

Washington  
 county well located

LANDOWNER: FARM Fresh  
P. O. Box 348  
Lake Village, ARK  
 (mailing address) 71653

description of formations encountered

from

to

	0	30
Med. CLAY	30	50
SAND	50	100
SAND		

WELL LOCATION:

sec. 17 T. 16 N. R. 7 E  
2 miles W of Arcola  
 (distance) (direction) (nearest town)

WELL PURPOSE: IRRIGATION  
 (home, irrigation, municipal, industrial)

WELL COMPLETION DATA:

- (1) diameter (inches) 10"
- (2) total depth (feet) 100'
- (3) static water level (feet) 32' below above top of ground.
- (4) casing PVC 80'  
 (material) (depth)
- (size) if telescope see back.
- (5) screen 20' 80'  
 (length) (depth to top)  
10" PVC  
 (size) (material)
- (6) pump 15 750  
 (HP) (yield gpm)  
ele  
 (type power)
- (7) electric log NO  
 (yes or no)  
X  
 (organization running log)
- (8) how well bottom plugged CAP




MAR 11 1988

Department of Natural Resources  
 Bureau of Land & Water Resources

DRILLERS REMARKS:

If well telescopes please sketch and show depths.

GROUND LEVEL

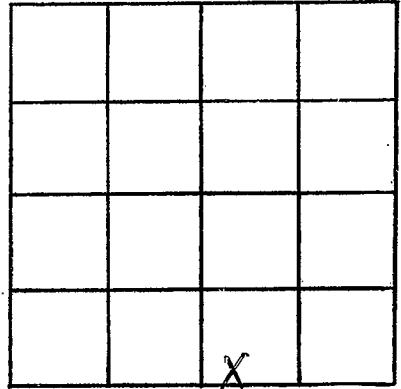

SECTION 17

Please indicate well location X.

ADDITIONAL INFORMATION

If more than one screen,  
show locations of each on sketch.