

MISSISSIPPI DEPARTMENT OF NATURAL RESOURCES

Bureau of Land and Water Resources

Southport Mall

P.O. Box 10631

Jackson, Mississippi 39209

WATER WELL DRILLERS LOG

WASHINGTON  
L 101  
166A

Coded

2-26 1988 Schultz Drilling Washington  
 date well completed firm name county well located


LANDOWNER: FARM Fresh  
P.O. Box 348  
Lake Village, Ark. 71653  
 (mailing address)

description of formations encountered	from	to
	<u>CLAY</u>	<u>0</u>
<u>Med. SAND</u>	<u>30</u>	<u>50</u>
<u>SAND</u>	<u>50</u>	<u>98</u>

WELL LOCATION:  
 sec. 20 T. 16 S. R. 7 E.  
2 miles W of ARCOLA  
 (distance) (direction) (nearest town)

WELL PURPOSE: IRRIGATION  
 (home, irrigation, municipal, industrial)

- WELL COMPLETION DATA:
- (1) diameter (inches) 10"
  - (2) total depth (feet) 98'
  - (3) static water level (feet) 32' ~~below~~ above top of ground.
  - (4) casing PVC 78'  
 (material) (depth)  
 (size) if telescope see back.
  - (5) screen 20' 78'  
 (length) (depth to top)  
10" PVC  
 (size) (material)
  - (6) pump 15 750  
 (HP) (yield gpm)  
ele  
 (type power)
  - (7) electric log no  
 (yes or no)  
X  
 (organization running log)
  - (8) how well bottom plugged CAP.

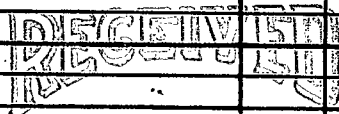


MAR 11 1988

Department of Natural Resources  
 Bureau of Land & Water Resources

DRILLERS REMARKS:

If well telescopes please sketch and show depths.

GROUND LEVEL

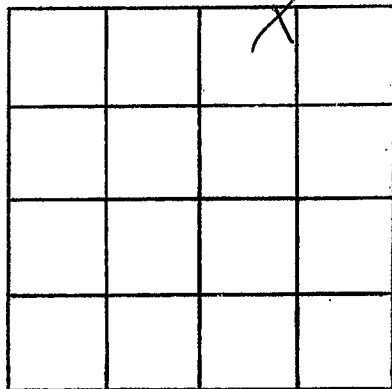

SECTION 20

Please indicate well location X.

ADDITIONAL INFORMATION

If more than one screen,  
show locations of each on sketch.