

MISSISSIPPI DEPARTMENT OF NATURAL RESOURCES

Bureau of Land and Water Resources

Southport Mall

P.O. Box 10631

Jackson, Mississippi 39209

WATER WELL DRILLERS LOG

WASHINGTON
2102

CODED

4-22-88 date well completed Schultz Drilling firm name Washington county well located

LANDOWNER: FRED BALLARD Rt. 1	description of formations encountered	from	to
Leland, MS (mailing address)	CLAY	0	20
	FINE SAND	20	40
	MEDIUM SAND	40	60
	COARSE SAND	60	114
WELL LOCATION: sec. 9 T. 16 N. R. 7 E. 2 miles W of Arcola (distance) (direction) (nearest town)			
WELL PURPOSE: IRRIGATION (home, irrigation, municipal, industrial)			
WELL COMPLETION DATA:			
(1) diameter (inches) 16"			
(2) total depth (feet) 114'			
(3) static water level (feet) 33' below top of ground.			
(4) casing PVC 74' (material) (depth)			
(5) screen 40' 74' (size) (length) (depth to top)			
(6) pump 50 (HP) 2500 (yield gpm) elc (type power)			
(7) electric log X (yes or no) No (organization running log)			
(8) how well bottom plugged CAP			
DRILLERS REMARKS:			


RECEIVED

JUN 16 1988

Department of Natural Resources
Bureau of Land & Water Resources

If well telescopes please sketch and show depths.

GROUND LEVEL

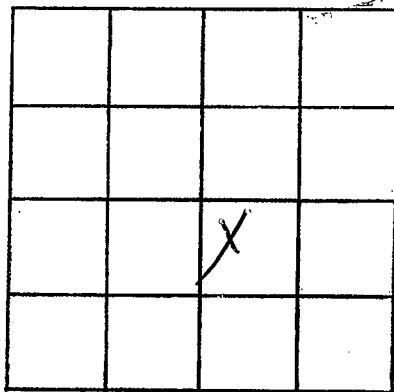

SECTION 9

Please indicate well location X.

ADDITIONAL INFORMATION

If more than one screen,
show locations of each on sketch.