

MISSISSIPPI DEPARTMENT OF NATURAL RESOURCES

Bureau of Land and Water Resources

Southport Mall

P.O. Box 10631

Jackson, Mississippi 39209

WATER WELL DRILLERS LOG

Permit Applied For L-103

CODED

5-23-88 date well completed

1988 Dyer Well firm name

Washington county well located

LANDOWNER: Hubert Farm Services

Description of formations encountered

from to

Gville, Ms. (mailing address)

Clay	0	30
Fine Sand	30	54
M Sand + Gravel	54	65
Sand + Gravel	65	75
M Sand + Gravel	75	85
Sand + Gravel	85	118

WELL LOCATION:

sec. 11 T. 16 N R. 7 E  
2 miles S of Arcola, Ms.  
(distance) (direction) (nearest town)

WELL PURPOSE: Irrigation (home, irrigation, municipal, industrial)

WELL COMPLETION DATA:

- (1) diameter (inches) 16"
- (2) total depth (feet) 118'
- (3) static water level (feet) \_\_\_\_\_ below top of ground.
- (4) casing PVC (material), \_\_\_\_\_ (depth), 16 (size) if telescope see back.
- (5) screen 40 (length), \_\_\_\_\_ (depth to top), 16 (size) (material)
- (6) pump 60 (HP), \_\_\_\_\_ (yield gpm), Gear (type power)
- (7) electric log No (yes or no), None (organization running log)
- (8) how well bottom plugged Plate

DRILLERS REMARKS:


RECEIVED

JUL 11 1988

Department of Natural Resources  
Bureau of Land & Water Resources

If well telescopes please sketch and show depths.

GROUND LEVEL

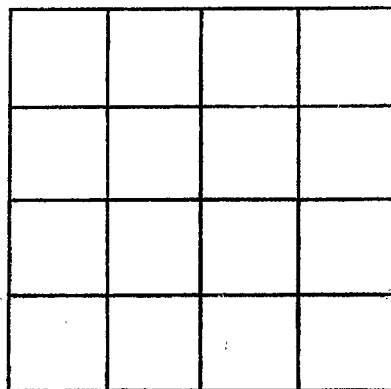

SECTION \_\_\_\_\_

Please indicate well location X.

ADDITIONAL INFORMATION

If more than one screen,  
show locations of each on sketch.