

MISSISSIPPI DEPARTMENT OF NATURAL RESOURCES

Bureau of Land and Water Resources

Southport Mall

P.O. Box 10631

Jackson, Mississippi 39209

WATER WELL DRILLERS LOG

Permit Applied For L 104

CODED

5-25-88 date well completed 1988 Dyer Well firm name Washington county well located

LANDOWNER: Huber Farms Services

description of formations encountered

from	to
0	34
34	60
60	88
88	116

G'ville, Ms (mailing address)

Clay
Fine Sand
M Sand + Gravel
Sand + Gravel

WELL LOCATION:

sec. 11 T 16 N R 7 E S 2 miles S of Arcola (distance) (direction) (nearest town)

WELL PURPOSE: Irrigation (home, irrigation, municipal, industrial)

WELL COMPLETION DATA:

- (1) diameter (inches) 16"
- (2) total depth (feet) 116'
- (3) static water level (feet) _____ below above top of ground.
- (4) casing PVC (material) (depth) 16" (size) If telescope see back.
- (5) screen 40' (length) (depth to top) 16" (size) (material)
- (6) pump 60 (HP) (yield gpm) Gear (type power)
- (7) electric log No (ygs of no) None (organization running log)
- (8) how well bottom plugged Plate

RECEIVED


JUL 11 1988

DRILLERS REMARKS:

Department of Natural Resources
Bureau of Land & Water Resources

If well telescopes please sketch and show depths.

GROUND LEVEL

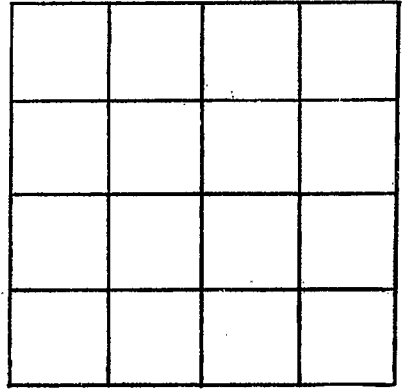

SECTION _____

Please indicate well location X.

ADDITIONAL INFORMATION

If more than one screen,
show locations of each on sketch.