

CODED

MISSISSIPPI DEPARTMENT OF NATURAL RESOURCES

Bureau of Land and Water Resources

Southport Mall

P.O. Box 10631

Jackson, Mississippi 39209

WATER WELL DRILLERS LOG

TEP  
88165-JLC-  
02 L105

6-14 1988  
date well completed

Dyer Well  
firm name

Washington  
county well located

LANDOWNER: Ken Crowe Farm  
Box 84  
Hollandale Ms.  
(mailing address)

description of formations encountered

from

to

Clay	0	35
Fine sand	35	56
Sand + gravel	56	64
Sand	64	70
M Sand + Gravel	70	100
Fine Sand	100	110

WELL LOCATION:

sec 12 T 16 N R 7  
3 miles S of Arnold  
(distance) (direction) (nearest town)

WELL PURPOSE: Irrigation  
(home, irrigation, municipal, industrial)

WELL COMPLETION DATA:

- (1) diameter (inches) 16"
- (2) total depth (feet) 110'
- (3) static water level (feet) \_\_\_\_\_ below above top of ground
- (4) casing steel (material), \_\_\_\_\_ (depth),  
16 if telescope see back. (size)
- (5) screen 40 (length), \_\_\_\_\_ (depth to top)  
16 (size), \_\_\_\_\_ (material)
- (6) pump 60 (HP), \_\_\_\_\_ (yield gpm)  
Gear (type power)
- (7) electric log No (yes or no)  
None (organization running log)
- (8) how well bottom plugged Plate

RECEIVED


JUL 11 1988

Department of Natural Resources  
Bureau of Land & Water Resources

DRILLERS REMARKS:

If well telescopes please  
sketch and show depths.

GROUND LEVEL

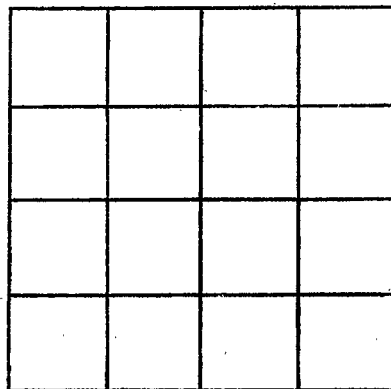

SECTION \_\_\_\_\_

Please indicate well location X.

ADDITIONAL INFORMATION

If more than one screen,  
show locations of each on sketch.